KANSAS


FORM 51 5M 11-44 PETROL

Graham County

Section 36 Township 6 Range 25W ~~25W~~

Well No. #1 W. Waggoner

Company Potash of America

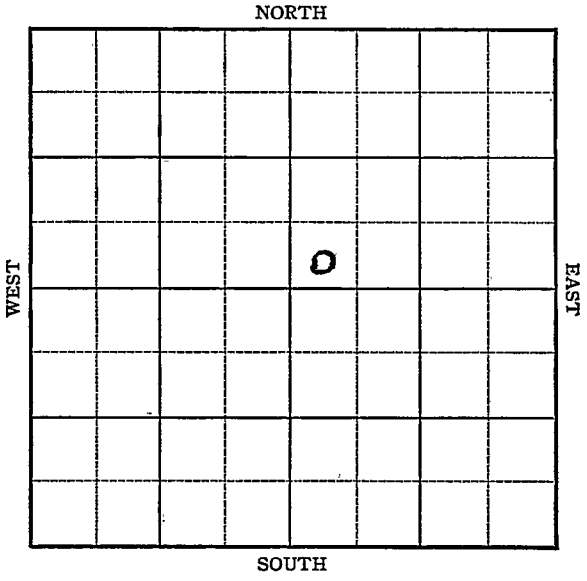

7

FORM 252-A
5M 12-45 PETROL

KANSAS

Graham county

Sec. 36 Twp. 6 R. 25W ~~25W~~

Well No. #1, W. Waggoner Farm

Potash of America Company

Wildcat


____ Ft. from N. Line

330 Ft. from S. Line

____ Ft. from E. Line

330 Ft. from W. Line

SW NE

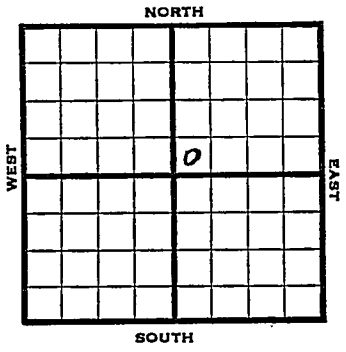

1946	REPORT
6/12	10" @ 198' Drlg. 1500'
6/18	Drlg 3645'
6/26	Topeka 3502 Lans 3700 BKC 3915 Cong 4172 Arb. 4237 TD 4287'

ABANDONED

200 BKS. 2-44 PETROL

KANSAS Kansas Pool Name Wildcat

No map

Map No. Sec. 36 Twp. 6 R. 35W


Well No. 1 W. Waggoner

Potash of America Company

FIRST REPORT Contractor

SW NE

SECTION PLAT

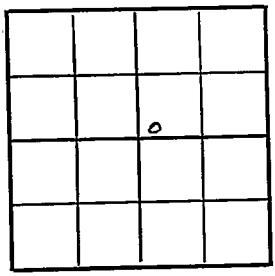

Ft. from N. Line

330 Ft. from S. Line

Ft. from E. Line

330 Ft. from W. Line

Graham County

Location

Rig up

Drilling and Remarks:

10" ∅ 198

1500

RECORD

Cased in., ft.

Sand

Gas

Oil

Total Depth

PRODUCTION

1st 24 hrs. Nat.

1st 24 hrs. after shot

Gas Cu. Ft.

Dry Hole

Abandoned

Date

JUN 12 1946 19 S. J. LEWIS Scout

FORM 26-230 BKS. 2-44 PETROL

Kansas Pool Name Wildcat

KANSAS
Map No. 13 / 130 Sec. 36 Twp. 6 R. 25W

Well No. 1 W. Waggoner


Potash of America Company

ABANDONED Contractor

E1, 2482

SW NE

SECTION PLAT

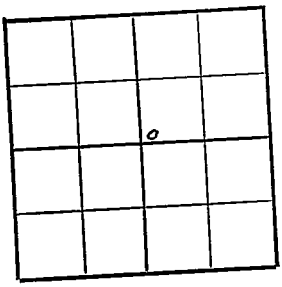

Ft. from N. Line

330 Ft. from S. Line

Ft. from E. Line

330 Ft. from W. Line

Graham County

Location

Rig up

Drilling and Remarks:

Topeka 3502
Lans 3700
BKC 3915
Conq. 4172
Ar 4237

RECORD

Cased in., ft.

Sand

Gas

Oil

Total Depth 4287

PRODUCTION

1st 24 hrs. Nat.

1st 24 hrs. after shot

Gas Cu. Ft.

Dry Hole

Abandoned

Date

JUN 26 1946 19

S. J. LEWIS Scout

FORM 26 200 BKS 2-44 PETROL

Kansas Pool Name Wildcat

Map No. ____ Sec. 36 Twp. 6 R. 25W


Well No. 1 W. Waggoner

Potash of America Company

Contractor

SW NE

SECTION PLAT

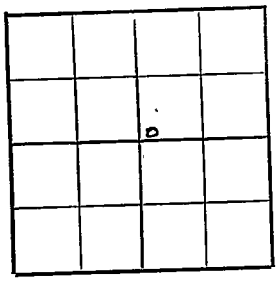

____ Ft. from N. Line

330 Ft. from S. Line

____ Ft. from E. Line

330 Ft. from W. Line

Graham County

Location

Rig up

Drilling and Remarks:

Reported
36-6-35W

RECORD

Cased ____ in., ____ ft.

Sand

Gas

Oil

Total Depth

PRODUCTION

1st 24 hrs. Nat.

1st 24 hrs. after shot

Gas ____ Cu. Ft.

Dry Hole

Abandoned

Date

JUN 26 1946 19

S. J. LEWIS Scout