


Section 4 Township 6 Range 27 W

Well No. # 1 Muirhead

Company Derby Oil

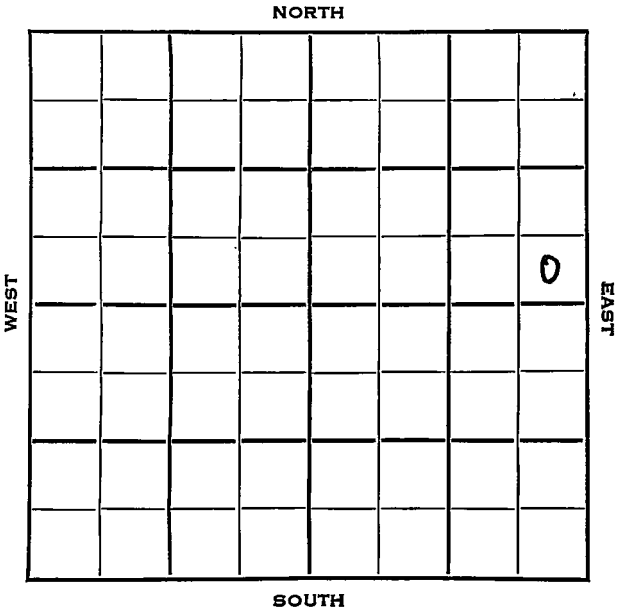

8

Sheridan

KANSAS


SEC.	4	TWP.	6	R.	27W
------	---	------	---	----	-----

WELL NO. #1 Muirhead FARM

COMPANY Derby Oil

CONTRACTOR Glen Peel Wildcat.

_____ Ft. from N. Line
 330
 _____ Ft. from S. Line
 330
 _____ Ft. from E. Line
 _____ Ft. from W. Line

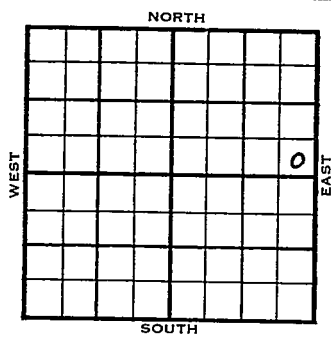

SE SE NE
 Continental F/O

	ELEVATION	REPORT
1953	2615'	
10/21	Spud 10-16-53 8" @ 223' Drlg 3095'	
10/28	Spud 10-16-53 D&A TD 3894' 8" @ 223' Heeb 3641', Br line 3664', Lans 3680' DST 3695-3730', opn 1/2 hrs., rec. 30' wtr, 1040# B KC 3889' TD 3894' D&A	

ABANDONED

County Sheridan State Kansas

Sec. 4 (Blk. 6 (Sur. 27W Map No.)
(Twp.) (Rge.)

Operator Derby Oil

Well No. 1 Farm Muirhead

Elev. 2615 Location SE SE NE

ABANDONED 0

330 Ft. From S Line NE

330 Ft. From E Line Quarter

Ist. Report OCT 28 1950

Completion

Remarks Wildcat

Glen Peel - Contr.

Spudding Date 10-16-53

Drlg. Data D & A TD 3894

8" @ 223 Heeb. 3641 Br. line 3664

Lans. 3680 DST 3695-3730 open 1/2 hr.

Rec. 30' wtr. 1040# B KC 3889 TD 3894

D & A