

Sheridan **KANSAS**

SECTION 6 TOWNSHIP 6 RANGE 26 W

WELL NO. #1 Randolph

COMPANY Imperial Drig.

NORTH

0							

WEST

EAST

SOUTH

13

Sheridan

KANSAS

SEC. 7	TWP. 6	R. 26W
-----------	-----------	-----------

WELL NO. #1 Randolph FARM

COMPANY Imperial Drlg.

CONTRACTOR Co. Tools

Semi-Wildcat


\_\_\_\_\_ Ft. from N. Line

\_\_\_\_\_ Ft. from S. Line

\_\_\_\_\_ Ft. from E. Line

\_\_\_\_\_ Ft. from W. Line

SW SW SW

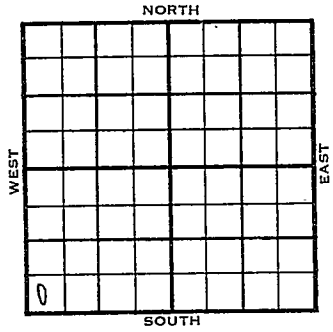

1955	ELEVATION	REPORT
------	-----------	--------

12-21	MIR	
-------	-----	--

County Sheridan Elev. \_\_\_\_\_  
 Sec. 7 Twp. 6 Rge. 26W  
 Company Imperial Drilg.  
 Farm Name Randolph No. 1

TOPS'	DEPTH	LOG	DATUM	Loc. in Sec.																																
Anb.				SW SW SW																																
Tr.																																				
H.																																				
Tr.																																				
Dg.																																				
Bl.																																				
L.				Geol. _____																																
K.C.				Contr. _____																																
B.K.C.				Co. tools _____																																
Ce.																																				
C.				Pool _____																																
M.				Semi-Wildcat																																
M.				W																																
K.				<table border="1"> <tr> <td></td> <td></td> <td></td> <td></td> </tr> <tr> <td></td> <td></td> <td></td> <td></td> </tr> <tr> <td></td> <td></td> <td></td> <td></td> </tr> <tr> <td></td> <td></td> <td></td> <td></td> </tr> <tr> <td></td> <td></td> <td></td> <td></td> </tr> <tr> <td></td> <td></td> <td></td> <td></td> </tr> <tr> <td></td> <td></td> <td></td> <td></td> </tr> <tr> <td></td> <td></td> <td></td> <td></td> </tr> </table>																																
Mz.																																				
Me.																																				
V.																																				
S.																																				
S.																																				
A.																																				
R.																																				
PE.																																				
G.																																				
T.D.																																				

FIRST REPORT  
 DEC 21 '55

Date Comm. M I R

*[Handwritten signature]*

Co.  
Lse.  
No.  
Sec.  
T.  
R.



JAN 11 '56 SLM 3834 = 3913

correct all DST 15' up hole

5 1/2 3819 CO 3775 16/

3766-68 6000 and 2 1/2

Boph 10 hrs no/w JAN 18 '56

PB 18/3669-72 4000A

sub 3 1/2 Boph 16 hrs PB 20/3628-

32 1000A sub 2 1/2 Boph 16 hrs.

dp 3775 sub 7 Boph. 8 hrs for

JAN 25 '56

Wood

FEB 1 '56

FEB 8 '56

FEB 15 '56

FEB 22 '56

FEB 29 '56

Ph P 91

Bopd + 17 to wt

gran 38

R.G.

MAR 8 1956