


Cloud

KANSAS

DX 78-1

Section 8 Township 6 Range 3W
Well No. #1 Blosser
Company Shawver-Armour, Inc.

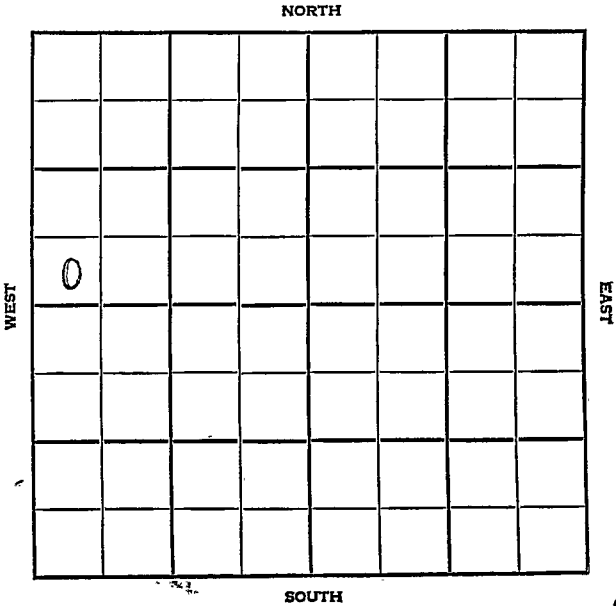

No County Map

County Cloud Elev. _____
 Sec. 8 Twp. 6 Rgs. 3W
 Company Shawver-Armour, Inc.
 Farm Name Blosser No. 1

TOPS	DEPTH	LOG	DATUM	Loc. in Sec.
Anb.				SW SW NW
Tr.				
Dg.				
BL.				
L.				Geol.
K.C.				Contr.
B.K.C.				Co. Tools
Ce.				
C.				Pool
M.				Wildcat
M.				
K.				
Mz.				
Me.				
V.				
S.				
S.				
A.				
R.				
PE.				
G.				
T.D.				FIRST REPORT

Date Comm. N.C.R.A. Phillips, Acp, DHM
 Location OCT 10 '56

6524 5 100

5.2

(No County Map)

County Cloud Elev. 1430
 Sec. 8 Twp. 6 Rge. 3W
 Company Shawver-Armour, Inc.
 Farm Name Blosser No. 1

TOPS	DEPTH	LOG	DATUM	Loc. in Sec.
Anh.				SW SW NW
Ip.	1888	1890		
H.	2130	2118		
Tr.	2150	2141		
Dg.	2166	2166		
Bl.				
L.	2222	2220		Geol.
K.C.				Contr.
B.K.C.	2559	2538		Co. Pools
Gr. <u>Mart</u>		2572		
C. 2		2684		
M.	2796	2798		Pool
M.				Wildcat
K.	2969	2970		
Mz. <u>Hont</u>	3080	3078		
Mo. <u>5410</u>	3289	3298		
V.	3352	3352		
S.	3542	3538		
S. <u>sh</u>		3568		
A.	3656	3654		
R. <u>spsd</u>		3589		
PE.				
G.				
TD.	3706			

ABANDONED

DEC 13 '56

Date Comm. N.C.R. Phillips, Acp, DHMLocation: DEC 17 '56✓ OCT 31 '56

NOV 7 '56

✓ NOV 13 '56

NOV

NOV 28 '56

11-19-56

858255

1135 1860 DEC 5 '563500 DEC

Ran Log

D.E.A.