


KANSAS

Grahamn

Section 9 Township 6 Range 22W

Well No. 1 Rush

Company Wilcox & B & R

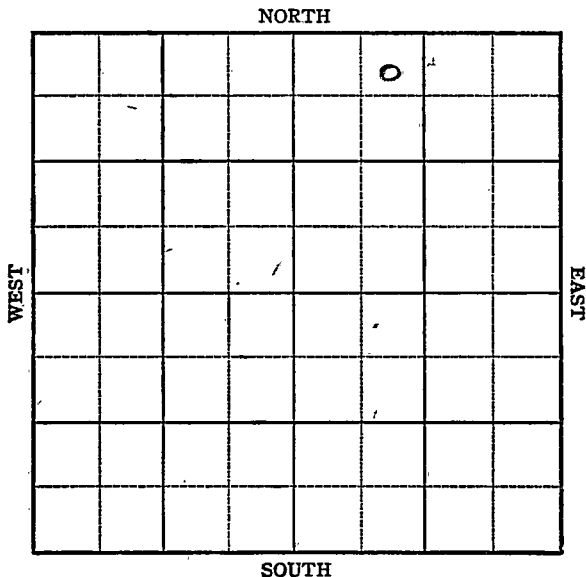

2

KANSAS

Graham County



Sec. 9 Twp. 6 R. 22-W

Well No. 1 Rush Farm


Wilcox & B & R Company

330 Ft. from N. Line

Ft. from S. Line

Ft. from E. Line

990 Ft. from W. Line

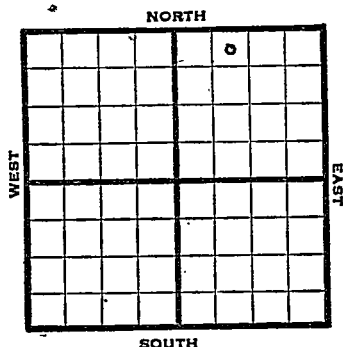

NE NW NE

REPORT

1947 Elev. 2250'

6/4 Location

6/10 RUR

6/21 "

6/24 8" @ 220'
Topeka 3271'
Lansing 3487'
Drlg 3640'

7/1 Arbuckle 3831'
T.D. 3873'
5" @ 3715'
RUST

7/8 Perf 3055-61
1000 acid
Pump 408 bbls oil in 24 hrs
2500 acid

7-16 "

7/22 3000 Acid.
12 shots 3567-71
12 shots 3569-43
1000 Acid

OVER

1947

7/29 12 shots. 3567-73' squeeze
15 shots. 3493-94' squeeze
35 shots. 3506-14'
Swb. 8-2/3 bbls. oil PH - 4 hrs.

8/6

"

8/13

"

8/20

"

8/27

Lans 3487'

Arbuckle 3831

5" @ 3706'

Perf Lans.

6000 Acid

Pump 297 Pot

Total Depth 3873'

COMPLETED

Map No. _____ Sec. 9 Twp. 6 R. 22W

Well No. 1 Rush

Wilcox & B & R Company

FIRST REPORT Contractor

NE NW NE


SECTION PLAT

330 Ft. from N. Line

_____ Ft. from S. Line

_____ Ft. from E. Line

990 Ft. from W. Line

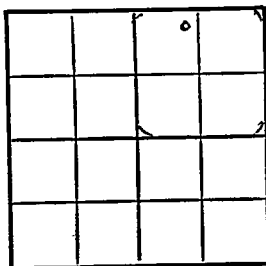

Graham County

Location X

Rig up _____

Drilling and Remarks:

RECORD

Cased _____ in., _____ ft.

Sand _____

Gas _____

Oil _____

Total Depth _____

PRODUCTION

1st 24 hrs. Nat. _____

1st 24 hrs. after shot _____

Gas _____ Cu. Ft.

Dry Hole _____

Abandoned _____

Date

JUN 4 1947 19

S. J. LEWIS Scout

Map No. 134 Sec. 9 Twp. 6 R. 22W

Well No. 1 Rush

Wilcox & B & R Company


COMPLETE

Contractor

NE NW NE

E1,2250

SECTION PLAT

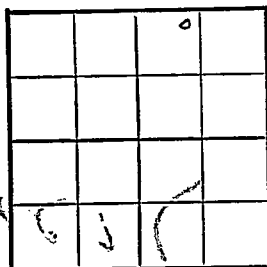

330 Ft. from N. Line

 Ft. from S. Line

 Ft. from E. Line

990 Ft. from W. Line

Graham County

Location

Rig up

Drilling and Remarks:

Loc 2487

Cr 43531

5" C3706

Prof. hant.

6000 acid

Prod. 297 Bx

33° E

RECORD

Cased in., ft.

Sand

Gas

Oil

Total Depth 3823

PRODUCTION

1st 24 hrs. Nat.

1st 24 hrs. after shot

Gas Cu. Ft.

Dry Hole

Abandoned

Date

AUG 27 1947

19

S. J. LEWIS

Scout