

Rooks

KANSAS

9


6S

20W

SECTION \_\_\_\_\_ TOWNSHIP \_\_\_\_\_ RANGE \_\_\_\_\_

WELL NO. #1 Steele

COMPANY Barnett Oil

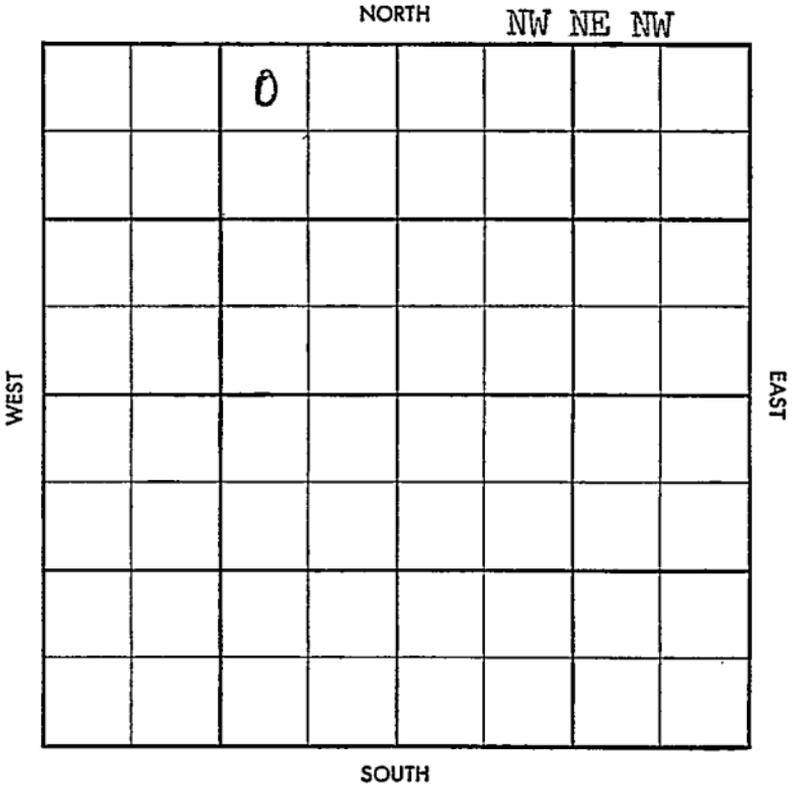

3



