

# KANSAS

Rooks


FORM 51 5M 10-41 PETROL

Section 9 Township 6 Range 20-W

Well No. 1 Steele

Company Derby & Crow

NORTH Wildcat

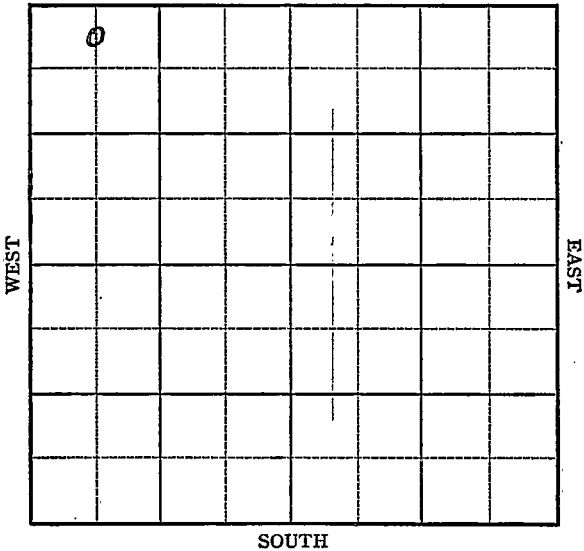


4

Sec. 9 Twp. 6 R. 20-W

Well No. #1 Steele Farm  
Derby & Crow Company

(Wildcat)

330 Ft. from N. Line  
 \_\_\_\_\_ Ft. from S. Line  
 \_\_\_\_\_ Ft. from E. Line  
660 Ft. from W. Line

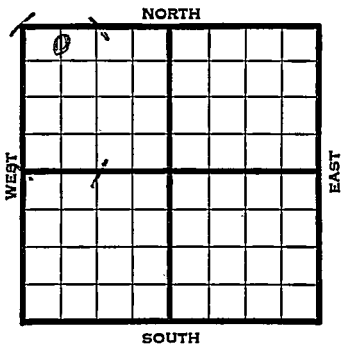

Elev. 2138

1941	REPORT
12/3	T.D. 155' Running casing.
12/11	8" @ 155' Drlg. 2721.
12/18	Lans. 3359 PKO 3549
	Drlg. 3560
12/24	Basal sand 3613' Granite Wash 3636'
	Granite 3638-39' T.D. 4" - 3602'
	RUST.
12/31	Swab 7 oil per hour, 4 hours.
1942	
1/8	Swab 13 oil in 2 hrs.
1/15	" " " "
1/22	" " " "
1/28	Lans. 3359' 4" - 3602'
	Granite 3638' Basal sand 3613'
	T.D. 3639'
	Potential 183 bbls., pump.
	29.8 Gravity
	<b>COMPLETED</b>

Map No. 133 Sec. 9 Twp. 6 R. 20W

Well No. 1 Steele

Derby & Crow Company

**COMPLETED** Contractor

C N $\frac{1}{2}$  NW NW  
330 Ft. from N. Line  
 \_\_\_\_\_ Ft. from S. Line  
 \_\_\_\_\_ Ft. from E. Line  
660 Ft. from W. Line

**SECTION PLAT**

o			

**RAY EAST POOL**

Location \_\_\_\_\_

Rig up \_\_\_\_\_

Drilling and Remarks:

*Lians 3359*  
*4" C 3602*  
*Granite 3638*  
*Barrel Sol 3613*  
*Pump 183 P.T.*  
*29 5/8*

**RECORD**

Cased \_\_\_\_\_ in., \_\_\_\_\_ ft.

Sand \_\_\_\_\_

Gas \_\_\_\_\_

Oil \_\_\_\_\_

Total Depth 3639

**PRODUCTION**

1st 24 hrs. Nat. \_\_\_\_\_

1st 24 hrs. after shot \_\_\_\_\_

Gas \_\_\_\_\_ Cu. Ft.

Dry Hole \_\_\_\_\_

Abandoned \_\_\_\_\_

Date

JAN 28 1942 19

S. J. LEWIS Scout

Rooks

KANSAS

Map No. 133 Sec. 9 Twp. 6 R. 20WWell No. 1 SteeleDerby & Crow Company

## FIRST REPORT

Contractor

C  $N\frac{1}{2}$  NW NW330 Ft. from N. Line

\_\_\_\_\_ Ft. from S. Line

\_\_\_\_\_ Ft. from E. Line

660 Ft. from W. Line

## SECTION PLAT

0			

## WILDCAT

Location \_\_\_\_\_

Rig up \_\_\_\_\_

Drilling and Remarks:

T.D. 155'

Running Casing  
Pipe

## RECORD

Cased \_\_\_\_\_ in., \_\_\_\_\_ ft.

Sand \_\_\_\_\_

Gas \_\_\_\_\_

Oil \_\_\_\_\_

Total Depth \_\_\_\_\_

## PRODUCTION

1st 24 hrs. Nat. \_\_\_\_\_

1st 24 hrs. after shot \_\_\_\_\_

Gas \_\_\_\_\_ Cu. Ft.

Dry Hole \_\_\_\_\_

Abandoned \_\_\_\_\_

Date

DEC 3 1941 19S. J. LEWIS Scout