

KANSAS

Graham

Section 1 Township 6 Range 24WWell No. 1 ChaseCompany B & R Drlg & Wilcox

Wildcat

	0						

NORTH

WEST

EAST

SOUTH

13

KANSAS

Graham



Sec. 1 Twp. 6 7 R. 24W

Well No. #1 Chase Farm

B & R Drlg. & Wilcox Company

Wildcat


 Ft. from N. Line

330' Ft. from S. Line

 Ft. from E. Line

990' Ft. from W. Line

SE SW SW

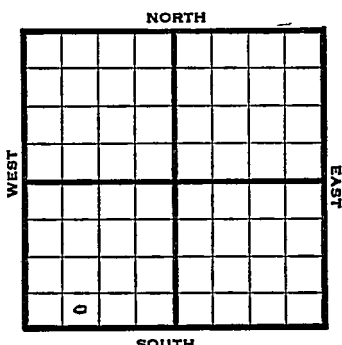

1948

Elev. 2482' REPORT

9/15 Surface Hole
9/21 8" @ 180
 D
 rlg 3650'
9/29 TD 4320'
10/6 Lans. 3806'
 Arb. 4290'
 TD 4320'

ABANDONED

Graham County Kansas State

Map No. Sec. 1 Twp. 6 R. 24W

Well No. 1 Chase


B & R Drilg. & Wilcox Company

FIRST REPORT

Contractor

SE SW SW

SECTION PLAT

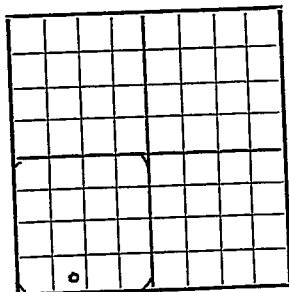

Ft. from N. Line

330 Ft. from S. Line

Ft. from E. Line

990 Ft. from W. Line

Wildcat

Remarks:

surface hole

Date

SEP 15 1948

Scout

S. J. LEWIS

Graham County Kansas State

Map No. 66 Sec. 1 Twp. 7 R. 24W

Well No. 1 Chase


B & R and Wilcox Company

CORRECTION

Contractor

SE SW SW

SECTION PLAT

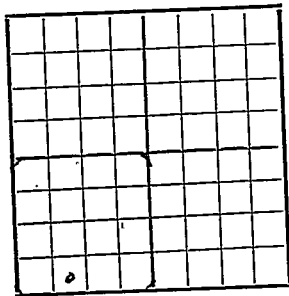

 Ft. from N. Line

330 Ft. from S. Line

 Ft. from E. Line

990 Ft. from W. Line

Wildcat

Remarks:

Reported 1-6-24W

Date

SEP 1 5 1948

Scout

S. J. LEWIS

Map No. 66 Sec. 1 Twp. 7 R. 24W

Well No. 1 Chase

B & R and Wilcox

Company


ABANDONED

Contractor

E. J. 2483

SE SW SW

SECTION PLAT

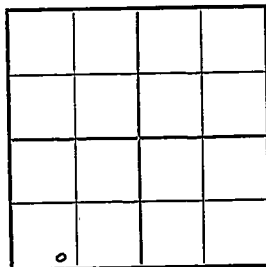

Ft. from N. Line

330

Ft. from S. Line

Ft. from E. Line

990

Ft. from W. Line

Graham County

Location

Rig up

Drilling and Remarks:

Loss 3806

Cr 4290

RECORD

Cased _____ in., _____ ft.

Sand _____

Gas _____

Oil _____

Total Depth 4920

PRODUCTION

1st 24 hrs. Nat. _____

1st 24 hrs. after shot _____

Gas _____ Cu. Ft.

Dry Hole _____

Abandoned _____

Date

OCT 6 1948

19

S. J. LEWIS

Scout