
FORM 51 25M 8-50 WESTERN

KANSAS

Section 10 Township 7 Range 24W

Well No. #1 Zohner

Company B & R. Drlg.

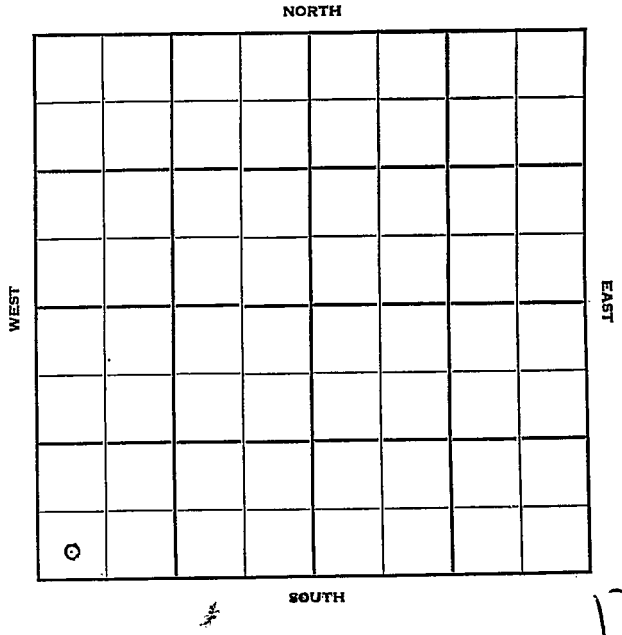

13

FORM 252-B
10M 11-50 PETROL.

Graham KANSAS

Sec. 10 Twp. 7 R. 24 W

Well No. # 1 Zohner Farm

B & R Drlg. Company

B & R Drlg. Contractor

Wildcat

Ft. from N. Line


330 Ft. from S. Line

Ft. from E. Line

330 Ft. from W. Line

SW SW SW

MCPC HAS SE OF 5 & SW OF

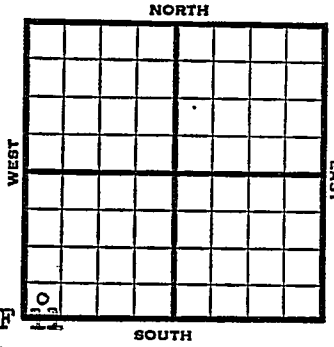

1951	Elev. 2442' REPORT
5/16	Spud 5-12-51 8" @ 179' Drlg. 1630'
5/29	Spud 5-12-51 D&A TD 4321 8" @ 179' Top 3541 Heeb. 3730 KC 3758 BKC 3975 Cong. 4164 Arb. 4274 TD 4321 D&A ABANDONED

FORM 275 FOR SALE BY KANSAS BLUE PRINT CO.


County Graham State Kansas

Sec. 10 (Blk. Twp.) 7 (Sur. Rge.) 24W Map No.

Operator B & R Drlg.

Well No. 1 Farm Zohner

Elev. Location SW SW SW

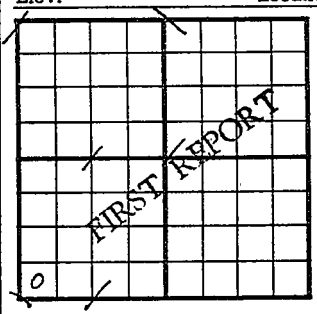

330 Ft. From S Line SW

330 Ft. From W Line Quarter

1st. Report MAY 16 1951

Completion

Remarks MCPC has SE of 5 & SW of 11

B & R Drlg. - Contr.

Spudding Date 5-12-51

Drlg. Data Wildcat

8" @ 179 drlg. 1630

J. E. TYRA

FORM 275 FOR SALE BY KANSAS BLUE PRINT CO.


County Graham State Kansas

Sec. 10 (Blk. Twp.) 7 (Sur. Rge.) 24W Map No.

Operator B & R Drlg.

Well No. 1 Farm Zohner

Elev. 2442 Location SW SW SW

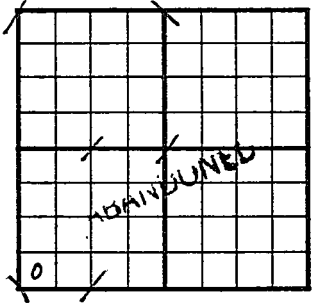

330 Ft. From S Line SW

330 Ft. From W Line Quarter

1st. Report

Completion MAY 29 1951

Remarks Wildcat

B & R Drlg. - Contr.

Spudding Date 5-12-51

Drlg. Data D & A TD 4321

8" @ 179 Top. 3541 Heeb. 3730

KC 3758 B KC 3975 Cong. 4164

Arb. 4274 TD 4321

D & A

J. E. TYRA