


KANSAS

Rooks

Section 10 Township 7 Range 17-W

Well No. #1 Moore

Company. Chas. Coats etal.

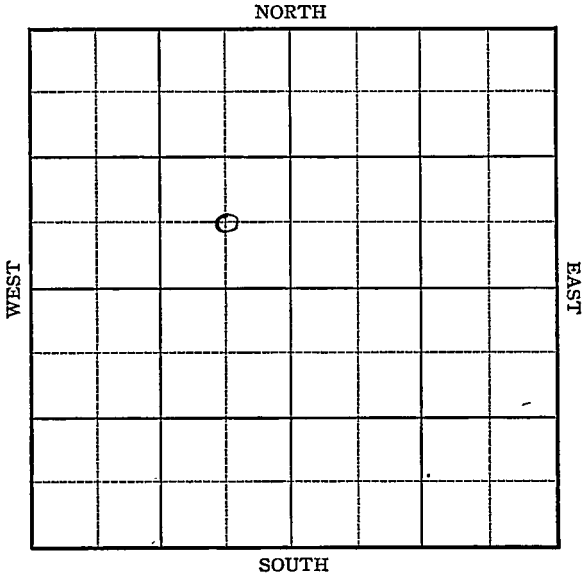

6

Sec. 10 Twp. 7 R. 17-W

Well No. #1 Moore Farm

Chas. Coats etal Company

Wildcat


 Ft. from N. Line

660 Ft. from S. Line

660 Ft. from E. Line

 Ft. from W. Line

Elev. 1804

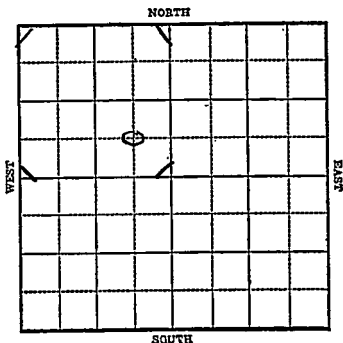

1943

R E P O R T

- | | | |
|------|--------------------------|--------------------|
| 4/7 | Rotary | Carter Oil Farmout |
| 4/14 | 8" @ 290' | |
| | Anky 1205' | |
| | Drlg. 1545' | |
| 4/21 | Topeka 2697 | |
| | SO 2725-28 | |
| | Lans 2947 | |
| | SO 2947-50, 2981-84 | |
| | -T.D. 3041-51 | |
| | Run Csg. | |
| 4/28 | 5" @ 3041 RUST. | |
| 5/5 | T.D. 3051 SSO & Water | |
| 5/12 | 2000 acid HFW | |
| | Squeeze off drill ahead. | |
| 5/22 | T.D. 3070 | |
| | Water squeezing off | |
| 5/26 | Drlg. 3100' | |
| 6/2 | Drlg. 3293 | |
| | Congl 3283 | |
| 6/9 | Arb 3332 | |
| | T. D. 3339 HFW | |

OVER

1943

6/16 PB 2800

5 shots 2717-19 $\frac{7}{8}$ no-show

6/23 Arb. 3332

5" @ 3041'

T.D. 3339'

HFW

ABANDONED

Rooks

KANSAS

Map No. 69 Sec. 10 Twp. 7 R. 17W

Well No. 1 Moore

Chas. Coats etal. Company

FIRST REPORT Contractor

C SE NW

SECTION PLAT

	o		

Ft. from N. Line

660 Ft. from S. Line

660 Ft. from E. Line

Ft. from W. Line

WILDCAT

Location _____

Rig up _____

Drilling and Remarks:

Carter Oil
Farmout

Rotary

RECORD

Cased _____ in., _____ ft.

Sand _____

Gas _____

Oil _____

Total Depth _____

PRODUCTION

1st 24 hrs. Nat. _____

1st 24 hrs. after shot _____

Gas _____ Cu. Ft.

Dry Hole _____

Abandoned _____

Date

APR 7 1943 19

S. I. LEWIS Scout

KANSAS **Rooks**
Map No. 64 Sec. 10 Twp. 7 R. 17W

Well No. 1 Moore

Chas Coats etal. Company

ABANDONED Contractor

C SE NW

 Ft. from N. Line

660 Ft. from S. Line

660 Ft. from E. Line

 Ft. from W. Line

SECTION PLAT

	o		

WILD CAT

Location

Rig up

Drilling and Remarks:

*Core # 3332
5'03041*

NFW.

RECORD

Cased in., ft.

Sand

Gas

Oil

Total Depth 7335

PRODUCTION

1st 24 hrs. Nat.

1st 24 hrs. after shot

Gas Cu. Ft.

Dry Hole

Abandoned

Date

JUN 23 1943 19

S. J. LEWIS Scout