

KANSAS


Rooks

FORM 5475M 1-42 PETROL

Section 10 Township 7 Range 18-W

Well No. #1 Bigge

Company Carter Oil

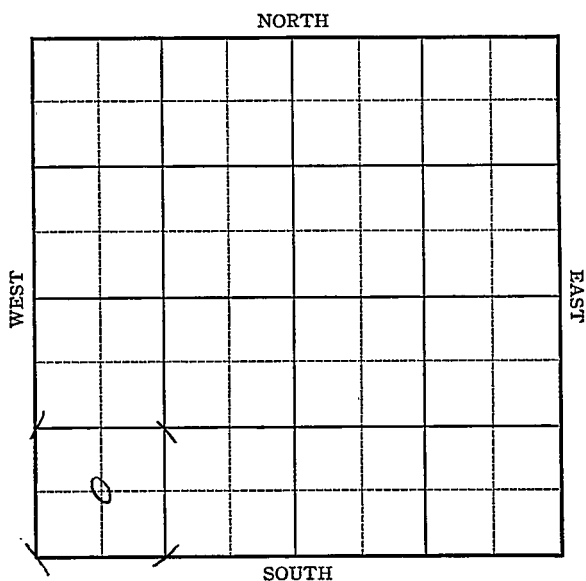

13

KANSAS

Rooks

Sec. 10 Twp. 7 R. 18-W

Well No. #1 Bigge Farm

Carter Oil Company


 Ft. from N. Line

660 Ft. from S. Line

 Ft. from E. Line

660 Ft. from W. Line

Sec. 1873

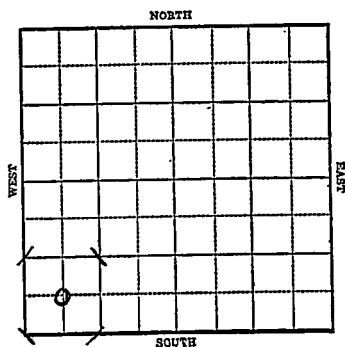

1943

R E P O R T

5/19 Location

5/26 Rotary

6/2 10" @ 268
1325' Run 9"

6/9 8" @ 1277' ~
Drlg. 2362'

6/16 Lans 3076
Drlg. 3292

6/23 Arb. 3516
T.D. 3591'
No shows.

ABANDONED

KANSAS

Map No. 64 Sec. 10 Twp. 7 R. 18WWell No. 1 Bigge

Carter Oil

Company

FIRST REPORT

Contractor

C SW SW


Ft. from N. Line

660 Ft. from S. Line

Ft. from E. Line

660 Ft. from W. Line

SECTION PLAT

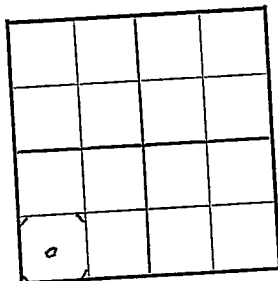

WILDCAT

Location XXX

Rig up

Drilling and Remarks:

RECORD

Cased _____ in., _____ ft.

Sand _____

Gas _____

Oil _____

Total Depth _____

PRODUCTION

1st 24 hrs. Nat. _____

1st 24 hrs. after shot _____

Gas _____ Cu. Ft.

Dry Hole _____

Abandoned _____

Date

MAY 19 1943S. J. LEWIS

Scout

Rooks

KANSAS

Map No. 64 Sec. 10 Twp. 7 R. 18WWell No. 1 Bigge

Carter Oil

Company

ABANDONED

Contractor

C SW SW

SECTION PLAT

6			

Ft. from N. Line

660 Ft. from S. Line

Ft. from E. Line

660 Ft. from W. Line

WIID CAT

Location

Rig up

Drilling and Remarks:

*Cor 8 3516**Noe howe*

RECORD

Cased _____ in., _____ ft.

Sand _____

Gas _____

Oil _____

Total Depth 3591

PRODUCTION

1st 24 hrs. Nat. _____

1st 24 hrs. after shot _____

Gas _____ Cu. Ft.

Dry Hole _____

Abandoned _____

Date

JUN 23 1943 19

S. J. LEWIS

Scout