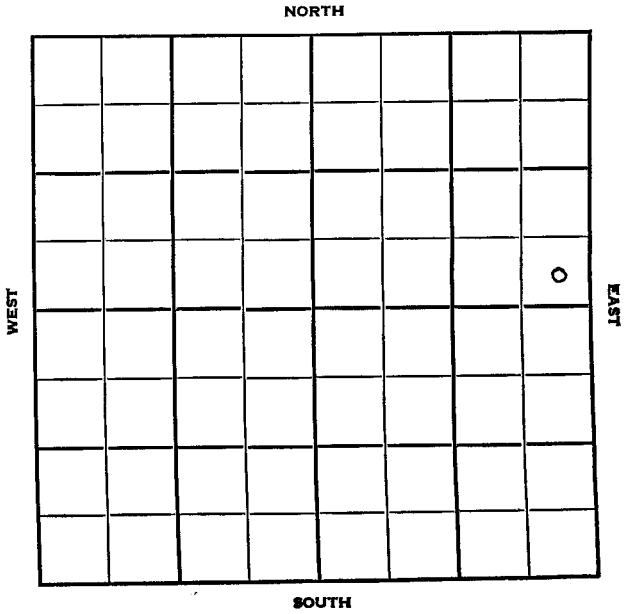


Section 11 Township 7 Range 21 WWell No. #1 KenyonCompany Veeder Supply & Development

SEC.	TWP.	R.
11	7	21 W

WELL NO.

1 Kenyon

FARM

COMPANY

Veeder Supply & Development

CONTRACTOR

Co. tools


Wildcat

_____ Ft. from N. Line

_____ Ft. from S. Line

_____ Ft. from E. Line

_____ Ft. from W. Line

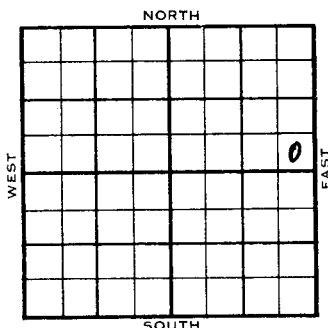

SE SE NE
SDX Lse - 5/8 Mile

Monsanto (Lion) DHM

ELEVATION

REPORT

1955 2181'

10/5 Comm. 9-30-55
8" @ 220/135
Drlg. 2250'
Anh. 1791'

10/12 Comm 9-30-55
8" @ 220/135

Anh	1791
H	3395
Tr	3418
L	3433
BKC	3628
A	3696
TD	3727

DST 3436-3515 open 1 hr Rec 145'
wm 1200/20" DST 3666-85
open 1/2 rec 3' mud 0#
D & A

ABANDONED

County Graham Elev. 2181
 Sec. 11 Twp. 7 Rge. 21W
 Company Veeder Supply & Development
 Farm Name Kenyon No. 1

TOPS	DEPTH	LOG	DATUM	Loc. in Sec.
Anh.	<u>1791</u>			<u>SE SE NE</u>
Tr.				
H.				
Tr.				
Dg.				
BL.				
L.				Geol.
K.C.				Contr.
B.K.C.				<u>Co. tools</u>
Ce.				Pool
C.				<u>Wildcat</u>
M.				
M.				
K.				
Mz.				
Ma.				
V.				
S.				
S.				
A.				
R.				
Pe.				
G.				
T.D.				

7-11-55
FIRST REPORT
OCT 5 '55

Date Comm. 9-30-55 Monsanto (Lion) DHM

8" @ 220/135 drlg. 2250

[Handwritten signature]

County Graham Elev. 21W
 Sec. 11 Twp. 7 Rge. 21W
 Company Veeder Supply & Development
 Farm Name Kenyom No. 1

TOPS	DEPTH	LOG	DATUM	Loc. in Sec.
Anh.	1791			SE SE NE
T.P.				
H.	3395		1214	
Tr.	3418		1237	
Dg.				
BL.				
L.	3433		1252	Geol.
K.C.				Contr.
B.K.C.	3628		1347	Co. tools
Ce.				Pool
C.				Wildcat
M.				
M.				
K.				
Mz.				
Ma.				
V.				
S.				
S.				
A	3696		1515	
R.				
Pe.				
G.				
TD	3727			

Date Comm. 9-30-55 OCT 1 2 1955

8" @ 220/135 DST 3436-3515 open 1 hr.

Rec. 145' wm 1200/20" DST 3666-85

open 1/2 hr. rec. 3' mud 0#

D & A