
FORM 51 25M 8-50 WESTERN Graham KANSAS

Section 11 Township 7 Range 21 W

Well No. # 1 Napue

Company Mid-Plains & Veeder

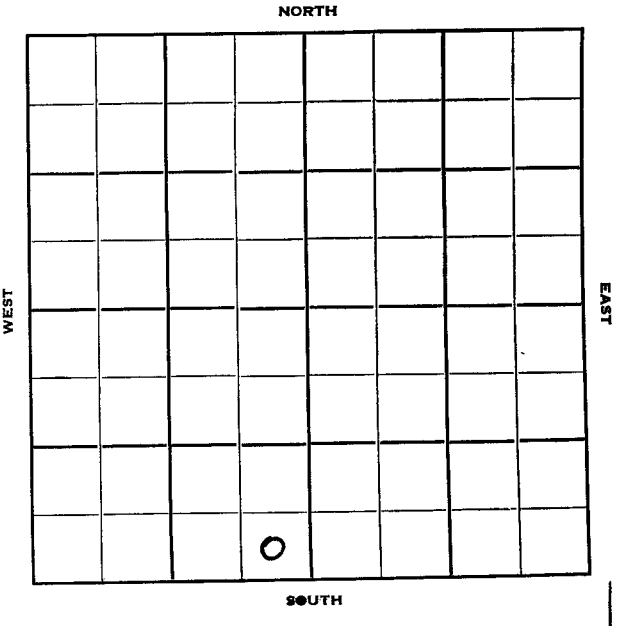

14

FORM 252-B
10M 10-50 PETROL

Graham

KANSAS

Sec. 11 Twp. 7 R. 21W

Well No. #1 Napue Farm

Mid-Plains & Veeder Company

Veeder Contractor

Wildcat


_____ Ft. from N. Line

330 Ft. from S. Line

330 Ft. from E. Line

_____ Ft. from W. Line

SE SE SW

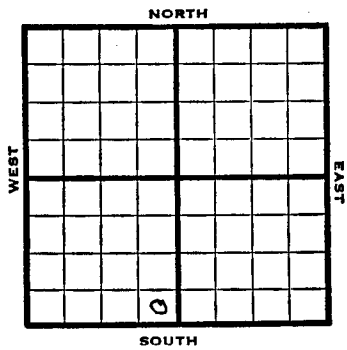

1952	Elev. 2134' REPORT
8/13	Location
8/20	"
8/27	"
9/3	RUR
9/10	8" @ 192' Anhy 1738'
	Drlg. 3025'
9/17	Spud 9-2-52
	D&A TD 3693' 8" @ 192'
	Anhy 1738 Heeb. 3342
	Tor. 3367 Lans. 3382
	DST 3369-92 open ½ hr. rec. 5' mud 725#
	DST 3419-45 open 1 hr. rec. 3' clean oil 60' SOCM 780#
	DST 3455-3512 open 1 hr. rec. 30' mud 930# B KC 3579 Cong. 3631
	DST 3638-44 open 1 hr. rec. 5' VSCOM 0# Arb. 3637 TD 3693' D&A

ABANDONED

FORM 275 FOR SALE BY KANSAS BLUE PRINT CO.


County Graham State Kansas

Sec. 11 (Blk. Twp.) 7 (Sur. Rge.) 21W Map No.

Operator Mid-Plains & Veeder

Well No. 1 Farm Hapue

Elev. Location SE SE SW

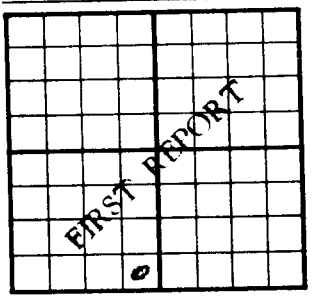

330 Ft. From S Line SW

330 Ft. From E Line Quarter

1st. Report AUG 13 1952

Completion

Remarks Sinclair $2000.

Veeder - Contr.

Spudding Date

Drlg. Data Wildcat

Location

J. G. McGEHEE

FORM 275 FOR SALE BY KANSAS BLUE PRINT CO.


County Graham State Kansas

Sec. 11 (Blk. Twp.) 7 (Sur. Rge.) 21W Map No.

Operator Mid-Plains & Veeder

Well No. 1 Farm Napue

Elev. 2134 Location SE SE SW

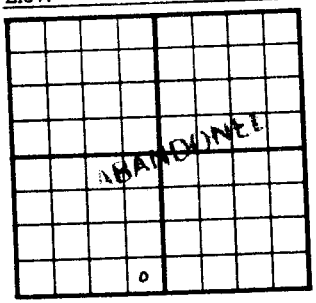

330 Ft. From S Line SW

330 Ft. From E Line Quarter

1st. Report

Completion SEP 17 1952

Remarks Wildcat
Veeder - Contr.

Spudding Date 9-2-52

Drlg. Data D & A TD 3693

8" @ 192 Anhy 1738 Heeb. 3342

Tor. 3367 Lans. 3382 DST 3369-92

open ½ hr. Rec. 5' mud 725# DST 3419-

45 open 1 hr. Rec. 3' clean oil

60' socm 780# DST 3455-3512 open 1 hr.

Rec. 30' mud 930# B KC 3579

Conq. 3631 DST 3638-44 open 1 hr.

Rec. 5' vsccm 0# Arb. 3637

TD 3693

D & A

J. G. McGEHEE