
Graham **KANSAS**

SECTION 11 TOWNSHIP 7 RANGE 23 W

WELL NO. #1 Hale

COMPANY J. A. Terteling & Sons & Harms-Burt

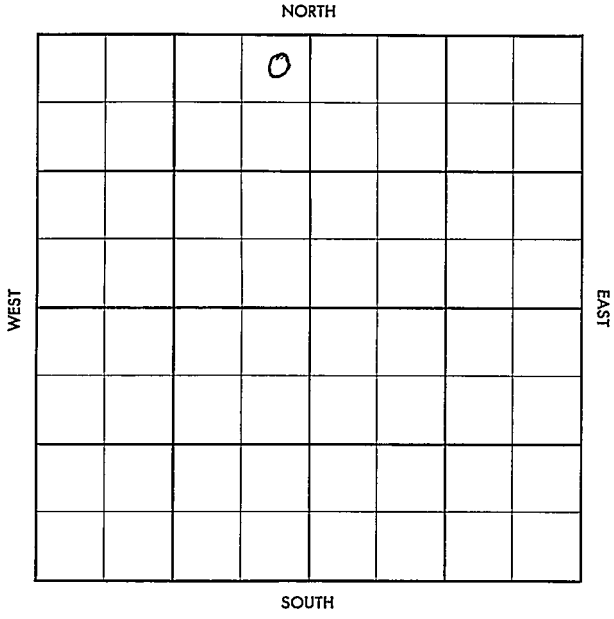

3

Graham KANSAS

SEC.	TWP.	R.
11	7	23W

WELL NO.

#1 Hale FARM

COMPANY

J. A. Terteling & Sons & Harms-Burt

CONTRACTOR

Harms-Burt

WILDCAT


_____ Ft. from N. Line

_____ Ft. from S. Line

_____ Ft. from E. Line

_____ Ft. from W. Line

NE NE NW

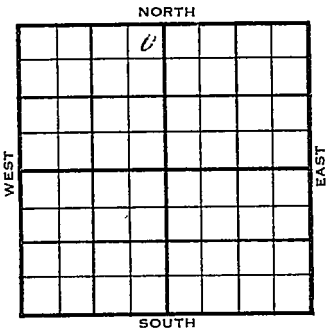

1955	ELEVATION 2385'	REPORT
12-7	Comm. 12-5-55	
12-21	8 5/8" @ 209/150 DST 3636-67 op 1 hr. rec. 60' mud, 1220# DST 3630-3705 op 1 hr. rec. 125' wcm, 1235# DST 3714-30 op 1 hr. rec 1065' sw, 1030/30" DST 3754-90 op ½ hr. rec. 30' mud, 1230/30" DST 3795-3850 op ½ hr. rec. 20' mud, 1055/30# D & A Tp. 3399 H. 3611 L. 3638-3652 A. 4035-4039 TD 4058-4062	

ABANDONED

DX-78

FORM 513 REV. SUNRAY

County Graham Elev.

Sec. 11 Twp. 7 Rge. 23W

Company J. A. Terteling & Sons & Harms-Burt

Farm Name Hale No. 1

TOPS	DEPTH	LOG	DATUM
Anh.			
Tp.			
H.			
Tr.			
Dg.			
B.L.			
L.			
K.C.			
B.K.C.			
Ce.			
C.			
M.			
M.			
K.			
Mz.			
Mo.			
V.			
S.			
S.			
A			
R.			
P€.			
G.			
T.D.			

Loc. in Sec. NE NE NW

Geol.

Contr. Harms-Burt

Pool Wildcat

FIRST REPORT DEC 7

Date Comm. 12-5-55

Co. Lse. No. Sec. T. R.

FORM 513 REV. SUNRAY

County Graham Elev. 2385 Co.

Sec. 11 Twp. 7 Rge. 23W

Company J. A. Terteling & Sons & Harms-Burt

Farm Name Hale No. 1

TOPS	DEPTH	LOG	DATUM
Anh.			
T.P.	3399		1014
H.	3611		1226
Tr.			
Dg.			
B.L.			
L.	3638	3652	1267
K.C.			
B.K.C.			
Ce.			
C.			
M.			
M.			
K.			
Mz.			
Mo.			
V.			
S.			
S.			
A	4035	4039	1654
R.			
Pe.			
G.			
T.D.	4058	4062	


Loc. in Sec. NE NE NW

Geol.

Contr. Harms-Burt

Lse.

Pool Wildcat

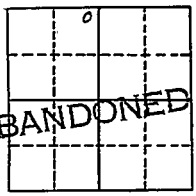

No.

Date Comm. 12-5-55 DEC 2 1 1955

Sec.

8 5/8" @ 209/150 DST 3636-67 open 1 hr.
rec. 60' mud 1220# DST 3630-3705
open 1 hr. rec. 124' wcm 1235#
DST 3714-30 open 1 hr. rec. 1065' sw
1030/30" DST 3754-90 open ½ hr.
rec. 30' mud 1230/30" DST 3795-3850
open ½ hr. rec. 20' mud 1055/30#

T.

D & A

R.