

Section 11 Township 7 Range 23-W

Well No. #1 Hale

Company Coppinger & Southern
MCPC SE/4 Sec 9.

NORTH

WEST

EAST

e							
o							

SOUTH

12

11

7

23W

Sec. _____ Twp. _____ R. _____

Well No. #1 Hale Farm _____

Coppinger & Southern Company _____

Contractor _____



MCPC SE/4 Sec. 9

330' Ft. from N. Line

Ft. from S. Line

Ft. from E. Line

330' Ft. from W. Line

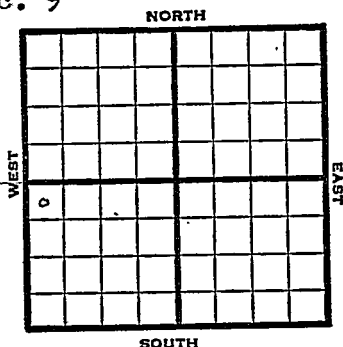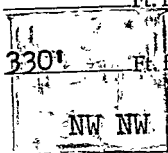

1950

Lev 2374' REPORT

4/5

Location

4/26

TD 4061'
8" @ 250'
Topeka 3399'
Heebner 3613'
Lans 3638'
Porosity 3724-29'
3732-35'
SSO 3777-91'
DST 3777-3800'
opn 20 mins.
Rec 4' mud
SSO 3805-08'
Arb. 4027'
TD 4061'
D&A
Aband.

ABANDONED

Map No. _____ Sec. 11 Twp. 7 R. 23WWell No. 1 HaleCoppinger & Southern CompanyMCPC SE/4 Sec. 9 Contractor

NW NW SW

SECTION PLAT

330 Ft. from N. Line

_____ Ft. from S. Line

_____ Ft. from E. Line

330 Ft. from W. LineGraham CountyLion, Sun, Amerada DHMLocation X

Rig up _____

Drilling and Remarks:

RECORD

Cased _____ in., _____ ft.

Sand _____

Gas _____

Oil _____

Total Depth _____

PRODUCTION

1st 24 hrs. Nat. _____

1st 24 hrs. after shot _____

Gas _____ Cu. Ft.

Dry Hole _____

Abandoned _____

Date

APR 5 1950 19J. E. TYRA

Scout

Map No. _____ Sec. 11 Twp. 7 R. 23WWell No. 1 HaleCoppinger & Southern Company


NW NW SW

Contractor

E 1-2374
SECTION PLAT330 Ft. from N. Line

_____ Ft. from S. Line

_____ Ft. from E. Line

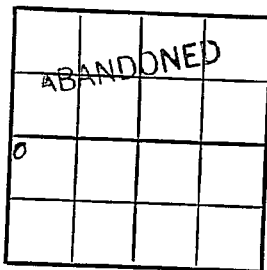330 Ft. from W. Line

Graham County

Location _____

Rig up _____

Drilling and Remarks:

8" C250
 Zopeka 3399
 Heilner 3613
 Lane. 3638
 Porosity 3724-29
 3732-35
 SSO 3777-71
 DST. 3777-3800

RECORD

Cased _____ in., _____ ft.

Sand _____

Gas _____

Oil _____

Total Depth 4061

PRODUCTION

1st 24 hrs. Nat. _____

1st 24 hrs. after shot _____

Gas _____ Cu. Ft.

Dry Hole _____

Abandoned _____

Date

APR 26 1950

19

J. E. TYRA

Scout

Open 20 min.
 Rec. 4' mud
 S50 3805-08
 arb 4027
 T.D. 4061

1930
 MAY 3
 D & A

Scout Cards	
Land Small Map	
Land Wall Map	
Tracings	
France Map	
Pierce Map	
Misc.	

SECOND
