

DX 78-1


Thomas

KANSAS

Section 12 Township 7S Range 33W

Well No. #1 Cooper

Company Virginia Drlg Co

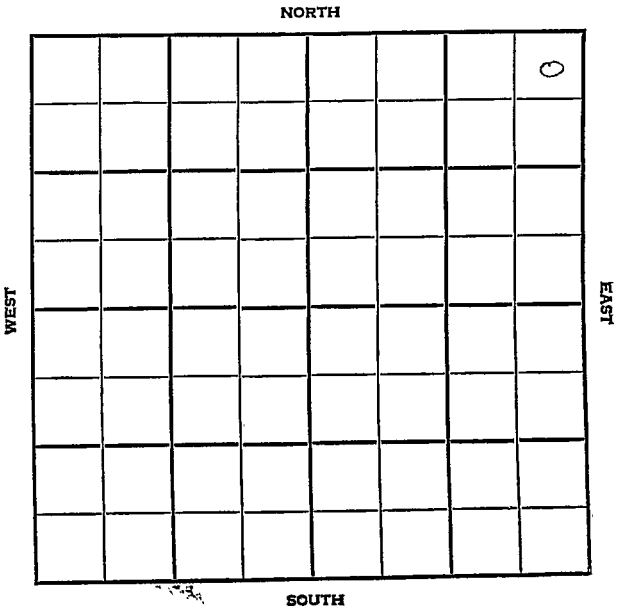

HOT FILE

Thomas KANSAS

SEC. 12 TWP. 7 S R. 33 W


WELL NO. # 1 Cooper FARM

COMPANY Virginia Drlg. Co. Inc.

CONTRACTOR

Bank Wildcat

_____ FT. FROM N. LINE
 _____ FT. FROM S. LINE
 _____ FT. FROM E. LINE
 _____ FT. FROM W. LINE

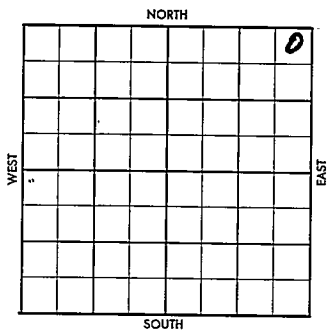

NE NE NE

SDX-DHC-\$3000.00

Don't advise Contract Section
 (WH6-DC54)

1956	ELEVATION	REPORT	
	3092' DF		
7/24	Mississippi Test appx 4900' To commence by Sept. 15, 1956 To complete by Oct. 15, 1956. (See DHC Agreement)		
8/22	Comm. 8-18-56 8" @ 809' w/185. Drlg. 2085' (FR Ticket)		
8-30	Ø 4475		
9-5	Comm 8-18-56 8" @ 309 w/185 Tops: M L 4046, Marm 4315, Ce 4450, Miss Li 4645, TD 4693 D 2085 Inspection RTD 4693 Abandoned 9-56		
			ABANDONED

County Thomas Elev. 3092 DF
 Sec. 12 Twp. 7S Rge. 33W
 Company Virginia Drlg. Co.
 Farm Name Cooper No. 1

TOPS	DEPTH	LOG	DATUM	Loc. in Sec.
Anh.				NE NE NE
TP.				
H.				
Tr.				
Dg.				
Bl.				Geol. <u>Lerke</u>
L.				Contr.
K.C.				
B.K.C.				
Ce.				
C.				
M.				Pool
M.				Rank WC
K.				
Mz.				
Ma.				
V.				
S.				
S.				
A.				
R.				
PE.				
G.				
TD.				

0
 FIRST REPORT
 AUG 22 '56

Date Comm. 8-18-56 Sunray Mid-Cont. DHM
8th 309 w/185; D 2085

33

17 57

Co.

Lse.

No.

Sec.

T.

R.

