


KANSAS

Brown

Section 12 Township 7 Range 21W ~~21E~~

Well No. 1 Roberts

Company Barnsdall etal

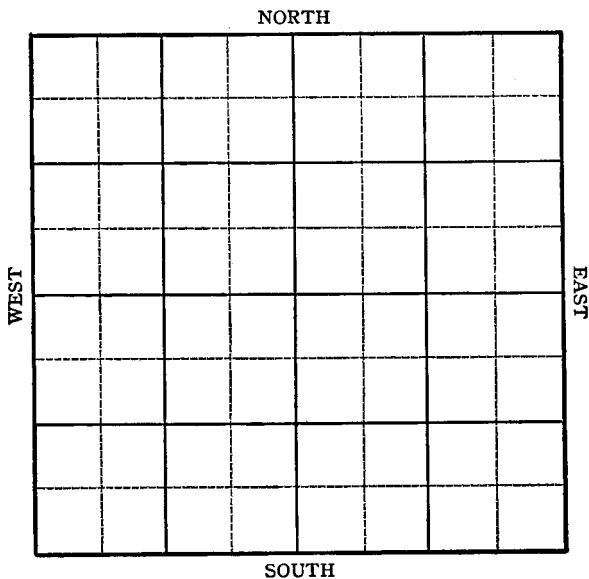

Sec. 12 Twp. 7 R. 21 E

Well No. #1 Roberts Farm


Barnsdall etal Company

330 Ft. from N. Line

 Ft. from S. Line

330 Ft. from E. Line

 Ft. from W. Line

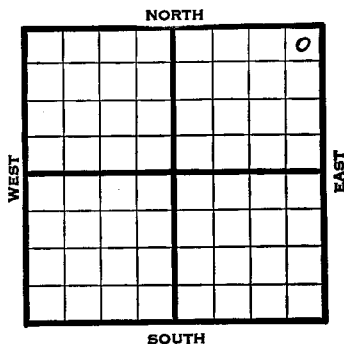

NE/c Elev. 2171

1945

REPORT


8/22 10" @ 160'
Drlg. 1220'
8/29 Anhy 1750
Drlg. 3245
9/5 Lens 3400
Arb. 3650
5" @ 3650
TD 3655 RUST
9/12 Sand 3696
TD 3700' HFW
PB
9/19 Arb. 3650
5" @ 3650
TD 3700'

ABANDONED

KANSAS
Pool Name Miscellaneous
KansasMap No. 10 Sec. 12 Twp. 7 R. 21EWell No. 1 RobertsBarusdall et al CompanyFIRST REPORT Contractor

NE/c

SECTION PLAT

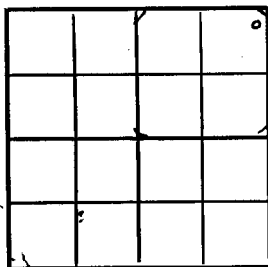330 Ft. from N. Line Ft. from S. Line330 Ft. from E. Line Ft. from W. LineBrown CountyLocation Rig up

Drilling and Remarks:

10"-160
1220*No map (copy)*

RECORD

Cased in. ft.Sand Gas Oil Total Depth

PRODUCTION

1st 24 hrs. Nat. 1st 24 hrs. after shot Gas Cu. Ft.Dry Hole Abandoned

Date

AUG 22 1945

19

S. J. LEWIS

Scout

KANSAS

Kansas Pool Name WildcatMap No. 65 Sec. 12 Twp. 7 R. 21WWell No. 1 RobertsBarnsdall

Company

CORRECTION

Contractor

NE/c

SECTION PLAT

330 Ft. from N. Line

Ft. from S. Line

330 Ft. from E. Line

Ft. from W. Line

			2

Graham County

Location

Rig up

Drilling and Remarks:

reported 12-7-21E
Brown County

RECORD

Cased _____ in., _____ ft.

Sand _____

Gas _____

Oil _____

Total Depth _____

PRODUCTION

1st 24 hrs. Nat. _____

1st 24 hrs. after shot _____

Gas _____ Cu. Ft.

Dry Hole _____

Abandoned _____

Date

SEP 1 9 1945

19

S. J. LEWIS


Scout

Kansas

Pool Name MiscellaneousMap No. KANSAS 12 Twp. 7 R. 21WWell No. 1 RobertsBarnsdall etal CompanyABANDONED

Contractor

ME/c

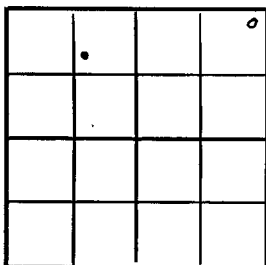E. 2171
SECTION PLAT330 Ft. from N. Line Ft. from S. Line330 Ft. from E. Line Ft. from W. LineGraham CountyLocation Rig up

Drilling and Remarks:

See 436505" 43650

RECORD

Cased in., ft.Sand Gas Oil Total Depth 3700

PRODUCTION

1st 24 hrs. Nat. 1st 24 hrs. after shot Gas Cu. Ft.Dry Hole Abandoned

Date

SEP 1 9 1945 19 S. J. LEWIS Scout