


FORM 51 25M 3-49 PETROL **Graham**

Section 12 Township 7 Range 22W

Well No. #1 Worcester

Company Keating Drlg.

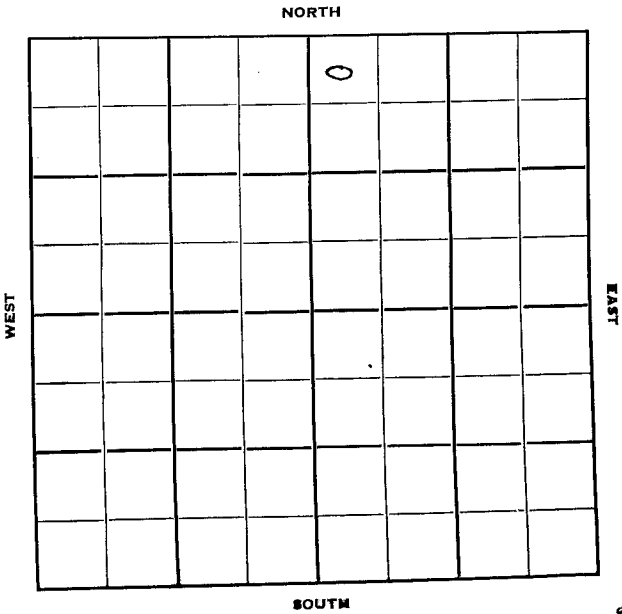

2

Graham

KANSAS



Sec. 12 Twp. 7 R. 22W

Well No. #1 Worcester Farm

Keating Drlg. Company

Keating Drlg. Contractor

Wildcat


330 Ft. from N. Line

Ft. from S. Line

Ft. from E. Line

330 Ft. from W. Line

NE $\frac{1}{4}$ NW NW NE

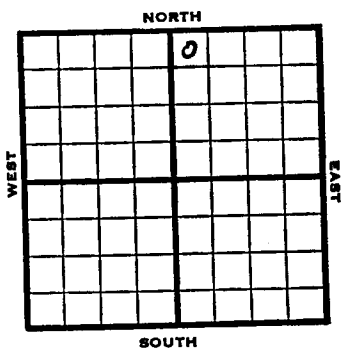

1952

Elev. 2245'

REPORT

11/5 Spud 11-2-52

8" @ 166'

Drlg. 208'

11/12 TD 3824' SD for pipe

Anhy 1842 Topeka 3245

11/19 Spud 11-2-52

D & A TD 3802' 8" @ 166 Anhy 1842

Top. 3245' Heeb 3451' Tor. 3476'

Lans. 3492' B KC 3681' Marm 3728'

Arb. 3768'

TD 3802' D & A

ABANDONED

County Graham State KansasSec. 12 (Blk. Twp.) 7 (Sur. Rge.) 22W Map No.Operator Keating Drlg.Well No. 1 Farm WorcesterElev. Location NW NW NE

			0		

FIRST REPORT


330 Ft. From N Line NE330 Ft. From W Line Quarter1st. Report NOV 5 1952

Completion

Remarks

Keating Drlg. - Contr.Spudding Date 11-2-52Drlg. Data Wildcat8" @ 166 drlg. 208

County Graham State Kansas
 Sec. 12 (Blk.) 7 (Sur.) 22W Map No.
 Operator Heating Drlg.
 Well No. 1 Farm Worcester
 Elev. 2245 Location NE 1/4 NE

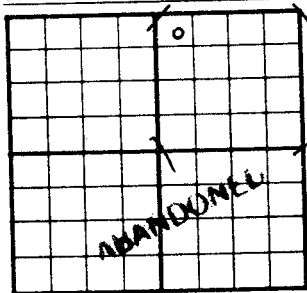

330 Ft. From N Line NE
 330 Ft. From W Line Quarter

1st. Report

Completion NOV 19 1952

Remarks Wildcat

Heating Drlg. - Contr.

Spudding Date 11-2-52

Drlg. Data D & A TD 3202

8" : 166 Anhy 1842 Top. 3245

Heeb. 3451 Tor. 3476 Lans. 3492

R VC 3631 Warm. 3728 Arb. 3768

TD 3202

D & A