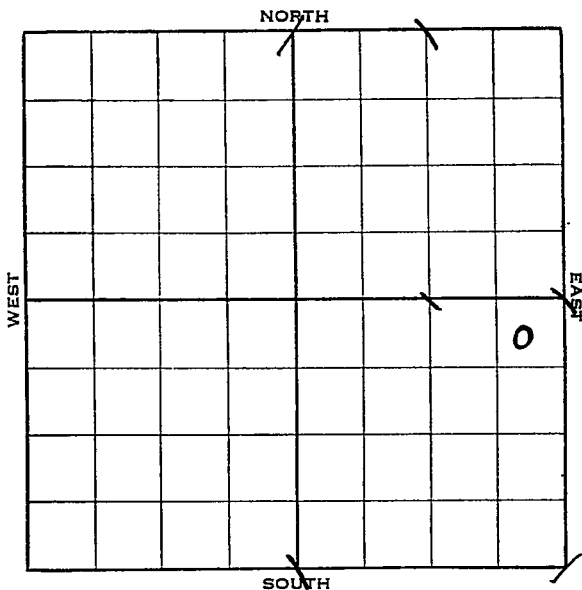


KANSAS

Rooks

Section 12 Township 7 Range 17-WWell No. 1 J. F. WhitfordCompany Carter

KANSAS

Rooks

Sec. 12 Twp. 7 R. 17-W

Well No. #1 J. F. Whitford Farm
Carter Company


440 Ft. from N. Line

Fr. from S. Line

440 Ft. from E. Line

Ft. from W. Line

Elev. 1753

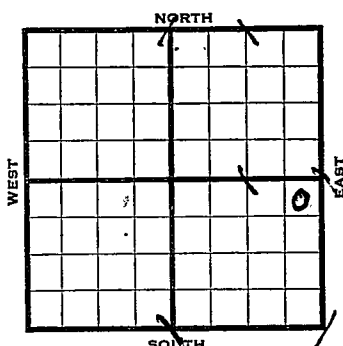

1938	REPORT
4/27	Cellar.
5/6	R U R
5/12	8" @ 529'.. WOC.
5/20	Anhy 1130'. Drlg. 2323'.
5/27	Topeka 2640'. S.OI-2670-75'.
	Small S.OI 2799-2801'.
	K. C. 2875'. S.O. 2896-97'.
	Drlg. 2935'.
6/3	Spotted Sat: 2934-40'.
	Cong. 3254'. Drlg. 3293'.
6/10	Arb. 3321'. T.D. 3355'.
	No shows. 4" at 2932'. RUST.
6/17	" " " " "
6/24	Drilled cement to 2942'.
	Perforated 60 shots 2893-2940'
	3750 acid. S. O.
	P. B. 2895'.
	108 shots 2657-75'.
	1000 acid.

OVER

6/30

Arb. 3321 4" 2932

T.D. 3355 PB 2855

1000 acid

3/4 BW & Rainbow S.O. P.H.
D & A

ABANDONED

⁵⁷
KANSASMap No. 64 Sec. 12 Twp. 7 R. 17WWell No. 1 J. F. WhitfordCarter

Company

Contractor


FIRST REPORT
NE SE440 Ft. from N. Line

_____ Ft. from S. Line

440 Ft. from E. Line

_____ Ft. from W. Line

SECTION PLAT

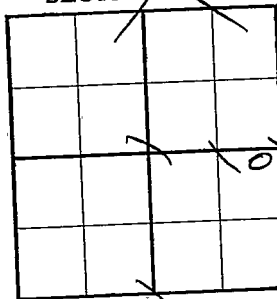

Location _____

Rig up _____

Drilling and Remarks:
Cellar

RECORD

Cased _____ in., _____ ft.

Sand _____

Gas _____

Oil _____

Total Depth _____

PRODUCTION

1st 24 hrs. Nat. _____

1st 24 hrs. after shot _____

Gas _____ Cu. Ft.

Dry Hole _____

Abandoned _____

Date

APR 27 1938

19

H. D. Hatfield Scout

Rooks KANSASMap No. 64 Sec. 12 Twp. 7 R. 17WWell No. 1 J. F. WhitfordCarter

Company

Contractor

ABANDONED

NE SE

440 Ft. from N. Line

Ft. from S. Line

440 Ft. from E. Line

Ft. from W. Line

SECTION PLAT

			0

Location _____

Rig up _____

Drilling and Remarks:

P.B. 2855 3/4 Bw
 1000 Acid
 Rainbow S.O. P.H.

D & A

RECORD

Cased 4 in., 2932 ft.Sand ARB 3321

Gas _____

Oil _____

Total Depth 3355

PRODUCTION

1st 24 hrs. Nat. _____

1st 24 hrs. after shot _____

Gas _____ Cu. Ft.

Dry Hole _____

Abandoned _____

Date

JUN 29 1938

19

H. D. Hatfield

Scout