DX 78-1


Graham

KANSAS

Section 13 Township 7 Range 22 W

Well No. # 1 Worcester

Company Jones, Shelburne & Farmer

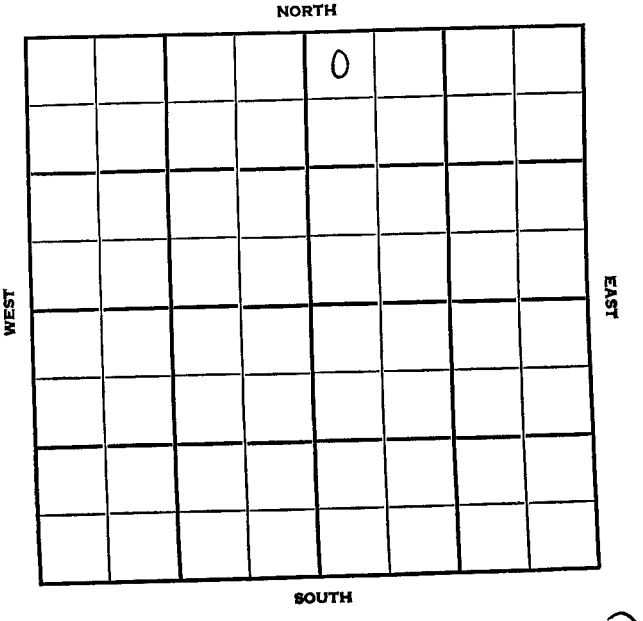

2

Graham KANSAS

SEC.	TWP.	R.
13	7	22 W

WELL NO.

1 Worcester FARM

COMPANY

Jones, Shelburne & Farmer

CONTRACTOR

Co. tools

Wildcat


330 Ft. from N. Line

Ft. from S. Line

Ft. from E. Line

330 Ft. from W. Line

NW NW NE

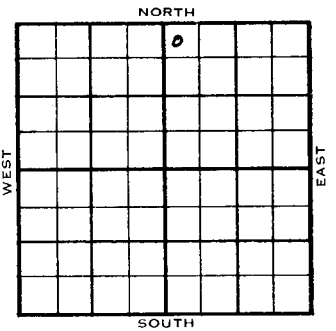

	ELEVATION	REPORT
1954	2151'	
8/11		Spud 8-8-54 8" @ 185 WOC
8/18		Spud 8-8-54 D&A TD 3745' 8" @ 185' Anhy 1890', Heeb 3362', Lans 3401', Arb. 3715' TD 3745' Schl Tops: Heeb 3364', Lans 3401', B KC 3594', Arb. 3715' D&A

ABANDONED

DX-78

FORM 275 FOR SALE BY KANSAS BLUE PRINT CO.


County Graham State Kansas

Sec. 13 (Blk. Twp.) 7 (Sur. Rge.) 22W Map No.

Operator Jones, Shelburne & Farmer

Well No. 1 Farm Worcester

Elev. Location NW NW NE

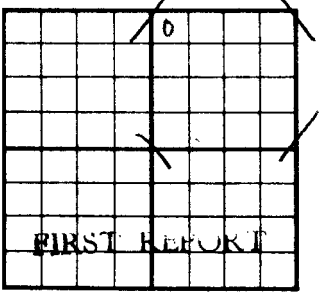

330 Ft. From N Line NE

330 Ft. From W Line Quarter

1st. Report AUG 11 1954

Completion

Remarks Co. tools

Spudding Date 8-8-54

Drlg. Data Wildcat

8" @ 185 WOC

9-3

FORM 275 FOR SALE BY KANSAS BLUE PRINT CO.


County Graham State Kansas

Sec. 13 (Blk. Twp.) 7 (Sur. Rge.) 22W Map No.

Operator Jones, Shelburne & Farmer

Well No. 1 Farm Worcester

Elev. 2151 Location NW NW NE

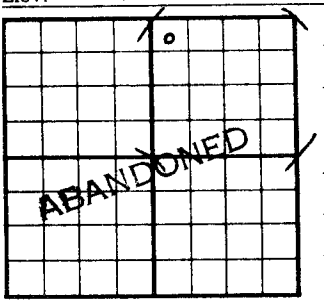

330 Ft. From N Line NE

330 Ft. From W Line Quarter

1st. Report

Completion AUG 1 8 1954

Remarks Wildcat

Co. tools

Spudding Date 8-8-54

Drlg. Data D & A TD 3745

8" @ 185 Anhy 1890 Heeb. 3362

Lans. 3401 Arb. 3715 TD 3745

SCHLUMBERGER TOPS:

Heeb. 3364 Lans. 3401 B KC 3594

Arb. 3715

D & A

FABEN GILSTRAP