

KANSAS


Rooks

Section 13 Township 7 Range 20W

Well No. 1 Chaill

Company Aladdin Pet.

Wildcat
NORTH

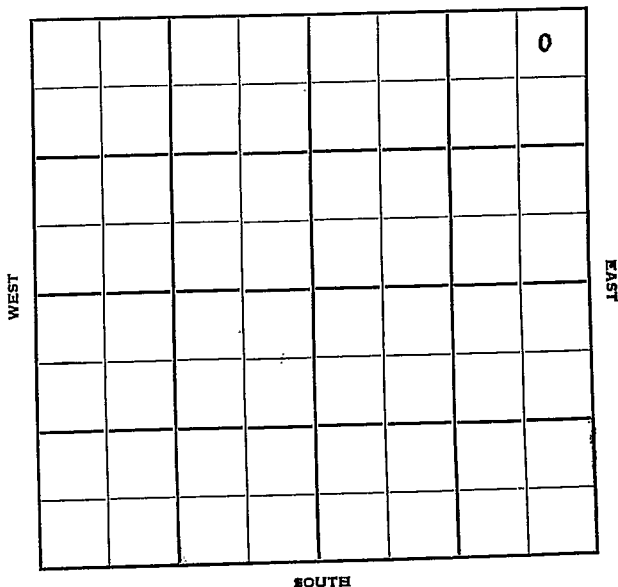

KANSAS

Rooks

Sec. 13 Twp. 7 R. 20W

Well No. #1 Chaill Farm

Aladdin Pet. Company

Wildcat


330' Ft. from N. Line

Ft. from S. Line

330' Ft. from E. Line

Ft. from W. Line

NE/C

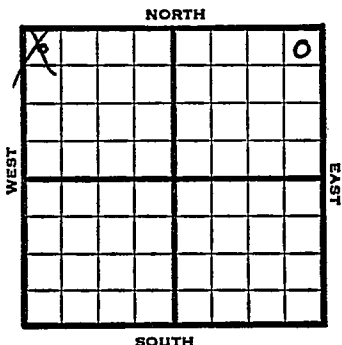

1949

Elev. 2046' REPORT

5/4

RUR

5/10

8" @ 180'

Drlg 2775'

5/17

Lans. 3269'

Arb. 3512'

DST 3512-20

TD 3520 Opn $\frac{1}{2}$ hrs.

Rec 20' cut mud

5" @ 3515'

5/25

"

6/1

"

6/7

Arb 3512'

5" @ 3515'

TD 3544'

6/8

Aband.

ABANDONED

Map No. _____ Sec. 13 Twp. 7 R. 20W

Well No. 1 Chaill

Aladdin Pet.

Company _____

FIRST REPORT

Contractor _____

NE/C


SECTION PLAT

330 Ft. from N. Line

_____ Ft. from S. Line

330 Ft. from E. Line

_____ Ft. from W. Line

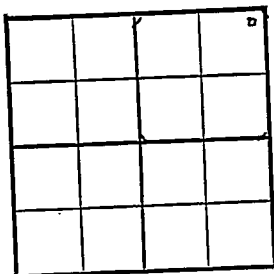

Rooks County

Location _____

Rig up _____

Drilling and Remarks:

R U R

RECORD

Cased _____ in., _____ ft.

Sand _____

Gas _____

Oil _____

Total Depth _____

PRODUCTION

1st 24 hrs. Nat. _____

1st 24 hrs. after shot _____

Gas _____ Cu. Ft.

Dry Hole _____

Abandoned _____

Date

MAY 4 1949 19

S. J. LEWIS

Scout

Rooks County Kansas State

Map No. 465 Sec. 13 Twp. 7 R. 20W

Well No. 1 Chaill

Aladdin Pet. Company

ABANDONED

Contractor

NE/C

E1.2046
SECTION PLAT

							6

330 Ft. from N. Line

 Ft. from S. Line

330 Ft. from E. Line

 Ft. from W. Line

Wildcat

Remarks:

CEL 8512

5" 03515

WD 8544

Date

JUN 8 1949

Scout

S. J. LEWIS