DX 78-1


Rooks

KANSAS

Section 14 Township 7 Range 19 W

Well No. #1 Reid

Company C. F. Kupp

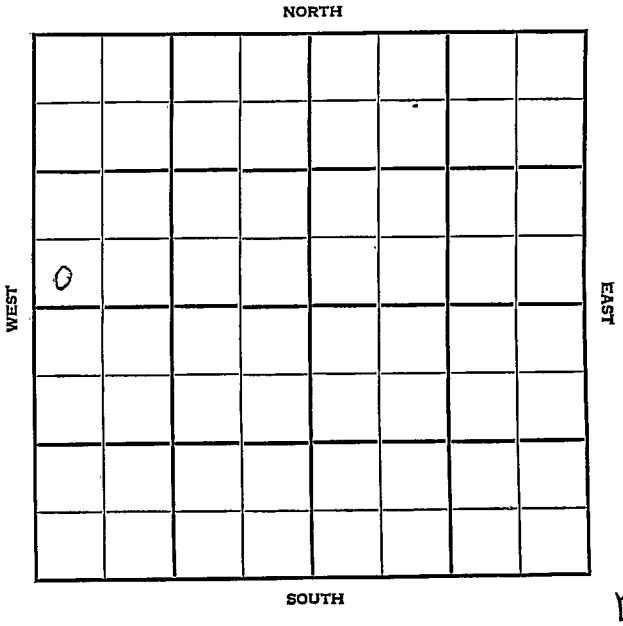

5

Rooks KANSAS

SEC.	TWP.	R.
14	7	19W

WELL NO. #1 Reid

COMPANY C. F. Rupp — FARM

CONTRACTOR Stearns


Grover

_____ Ft. from N. Line

_____ Ft. from S. Line

_____ Ft. from E. Line

_____ Ft. from W. Line

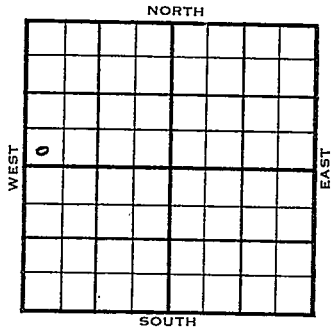

SW SW NW

1955	ELEVATION 1931'	REPORT
8/31	M I R	
9/14	Comm 9-1-55 ± TP 2890 H 3097 L 3132 BKC 3352 C 3406 TD 3462 8 5/8" @ 186; no show D & A	

ABANDONED

DX-78

FORM 513 REV. SUNRAY

County Hooks Elev.

Sec. 11 Twp. 7 Rge. 19W

Company G. F. Rupp

Farm Name Reid No. 1

TOPS	DEPTH	LOG	DATUM
Anh.			
T.P.			
H.			
Tr.			
Dg.			
B.L.			
L.			
K.C.			
B.K.C.			
Ce.			
C.			
M.			
M.			
K.			
Mz.			
Mg.			
V.			
S.			
S.			
A			
R.			
P€.			
G.			
T.D.			

Loc. in Sec. SW SWNW

Geol.

Contr. Stearns

Pool Grover

0 AUG 31 '55

FIRST REPORT

Date Comm. M I R

Co. Lse. No. Sec. T. R.

FORM 513 REV. SUNRAY

County Rooks Elev. 1931

Sec. 14 Twp. 7S Rge. 19W

Company C. F. Rupp

Farm Name Reid No. 1

TOPS	DEPTH	LOG	DATUM
Anh.			
T.P.	2890		959
H.	3097		1166
Tr.			
Dg.			
B.L.			
L.	3132		1201
K.C.			
B.K.C.	3352		1421
Ce.			
C.	3406		1475
M.			
M.			
K.			
Mz.			
Mo.			
V.			
S.			
S.			
A			
R.			
P€.			
G.			
T.D.	3462		

Loc. in Sec. SW SW NW

Geol.

Contr. Stearns

Pool Grover

ABANDONED

SEP 1 4 1955

Date Comm. 9-1-55

8-5/8" 186; no show

D & A

Co. Lse. No. Sec. T. R.