
FORM 51 25M 8-50 WESTERN Rooks KANSAS

Section 14 Township 7 Range 19W

Well No. #1 Burton

Company Magnolia

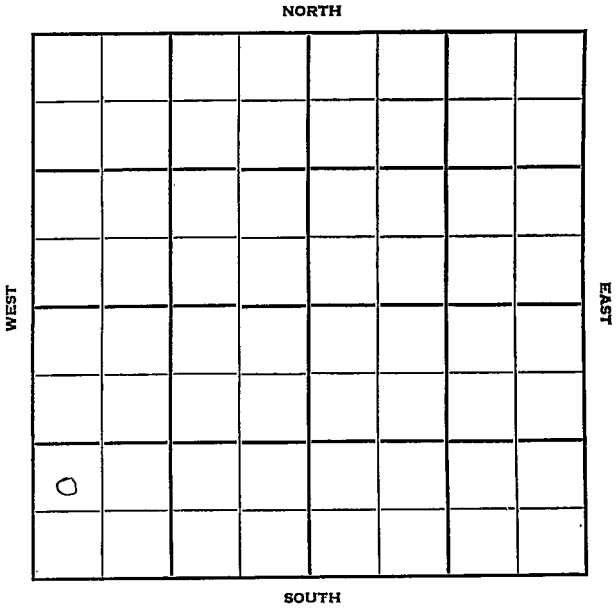

13

FORM 252-B
10M 11-50 PETROL

Rooks County, KANSAS

Sec. 14 Twp. 7 R. 19 W

Well No. # 1 Burton Farm

Magnolia Company

Contractor

Grover Pool


Ft. from N. Line

990 Ft. from S. Line

Ft. from E. Line

330 Ft. from W. Line

NW SW SW

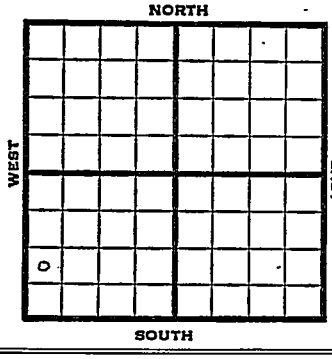

1951	Elev. 1946' REPORT
9/5	Location
10/17	Spud 9-12-51 Oil Well TD 3416 10" @ 184 Heeb. 3090 Tor. 3113 Lans. 3129 DST 3096-3149 opn 1hr Rec. 280' hocm DST 3156-3204 opn 1 hr Rec. 35' hocm DST 3272-91 opn 1 hr Rec. 10' socm Arb. 3397-3400 TD 5" @ 3398 DD 3406 B/3 qt. oil ph 500 A No inc. DD 3416 500 A B/4 go 2 bwpd SP 3390 47/3320-36 20/3343-50 2000A S/5 bopd 3 hr SP 3318 12/3303-12 S/2 bo 2 bwph SP 3295 30/3282-92 S/1½ bo ½ bwph 5 hrs. DP to 3315 2000 A S/4 bo 1 bwph DP to 3390 P/10 bo 120 bw 12 hr. PB 3390 Comp. 129 bo 31 bwpd COMPLETED

FORM 275 FOR SALE BY KANSAS BLUE PRINT CO.


County Rooks State Kansas

Sec. 14 (Blk. Twp.) 7 (Sur. Rge.) 19W Map No.

Operator Magnolia

Well No. 1 Farm Burton

Elev. Location NW SW SW

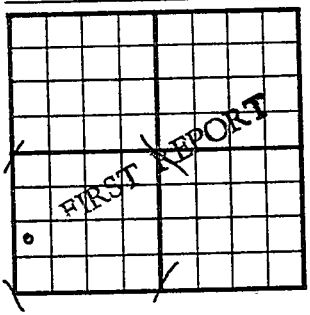

990 Ft. From S Line SW

330 Ft. From W Line Quarter

1st. Report SEP 5 1951

Completion

Remarks

Spudding Date

Drlg. Data Grover Pool

Location

J. E. TYRA

FORM 275 FOR SALE BY KANSAS BLUE PRINT CO.


County Rooks State Kansas

Sec. 14 (Blk. Twp.) 7 (Sur. Rge.) 19W Map No.

Operator Magnolia

Well No. 1 Farm Burton

Elev. 1946 Location NW SW SW

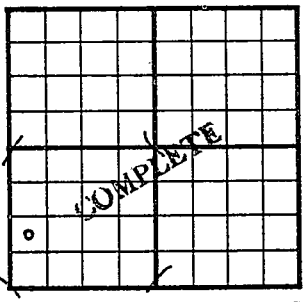

990 Ft. From S Line SW

330 Ft. From W Line Quarter

Ist. Report

Completion OCT 17 1951

Remarks Grover Pool

Barnett Drlg. - Contr.

Spudding Date 9-12-51

Drlg. Data Oil well TD 3416

10" @ 184 Heeb. 3090 Tor. 3113

Lans. 3129 DST 3096-3149 open 1 hr.

Rec. 280' hocm DST 3156-3204 open 1 hr.

Rec. 35' hocm DST 3272-91 open 1 hr.

Rec. 10' socm Arb. 3397-3400 TD 5" @ 3398

DD 3406 B/ 3 qt. oil ph 500 A no inc.

DD 3416 500 A B/ 4 go .2 bwpd

SP 3390 47/ 3320-36 20/ 3343-50

2000 A S/ 5 bopd 3 hr. SP 3318

12/ 3303-12 S/ 2 bo 2 bwph SP 3295

30/ 3282-92 S/ 1½ bo ½ bwph 5 hr.

DP to 3315 2000 A S/ 4 bo 1 bwph

DP to 3390 P/ 10 bo 120 bw 12 hr.

PB 3390 Comp. 129 bo 31 bwpd

J. E. TYRA