

Section 15 Township 7 Range 25WWell No. 1 BoydCompany Derby Oil et al

Wildcat

NORTH

WEST								
					6			

EAST

SOUTH

15

KANSAS

Graham

25W

Sec. 15 Twp. 7 R. 25W

Well No. #1 Boyd Farm

Derby Oil et al Company

Wildcat

Ft. from N. Line

330'


Ft. from S. Line

Ft. from E. Line

330'

Ft. from W. Line

SW SE

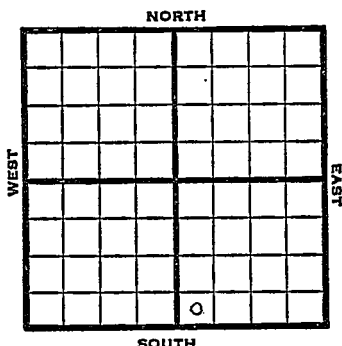

1948

Elev 2549'

REPORT

11/10

8" @ 146'

Drlg. 795'

11/16

Drlg. 2850'

11/23

Topoka 3497'

Lansing 3739'

Drlg 3800'

11/30

Drlg 4235'

1/12/8

BKC 3947'

Arb. 4237'

5" @ 4240'

TD 4247'

1000' water $\frac{1}{2}$ hr PB

12/15

TD 4247'

Arb. 4237'

Aband.

ABANDONED

Map No. _____ Sec. 15 Twp. 7 R. 25W


Well No. 1 Boyd

Derby Oil et al. _____ Company

FIRST REPORT _____ Contractor

SW SE

SECTION PLAT

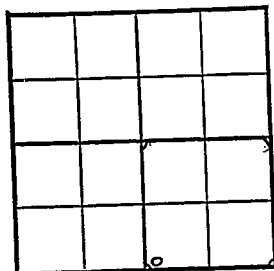

_____ Ft. from N. Line

330 Ft. from S. Line

_____ Ft. from E. Line

330 Ft. from W. Line

Graham County

Location _____

Rig up _____

Drilling and Remarks:

8" @ 146

drlg. 795

RECORD

Cased _____ in., _____ ft.

Sand _____

Gas _____

Oil _____

Total Depth _____

PRODUCTION

1st 24 hrs. Nat. _____

1st 24 hrs. after shot _____

Gas _____ Cu. Ft.

Dry Hole _____

Abandoned _____

Date

NOV 10 1948 19

S. J. LEWIS Scout

Map No. 67 Sec. 15 Twp. 7 R. Well No. 1 Boyd

Derby Oil etal.

Company

ABANDONED

Contractor

SW SE

E12549
SECTION PLAT

Ft. from N. Line

330


Ft. from S. Line

Ft. from E. Line

330

Ft. from W. Line

Graham County

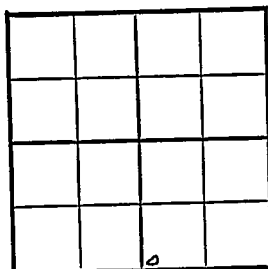

Location

Rig up

Drilling and Remarks:

Cust 4287

RECORD

Cased _____ in., _____ ft.

Sand _____

Gas _____

Oil _____

Total Depth 4247

PRODUCTION

1st 24 hrs. Nat. _____

1st 24 hrs. after shot _____

Gas _____ Cu. Ft.

Dry Hole _____

Abandoned _____

Date

DEC 15 1948 19

S. J. LEWIS

Scout