Sheridan


KANSAS

SECTION 15 TOWNSHIP 7 RANGE 28W

WELL NO. #1 Watkins

COMPANY ~~Empire Drlg.~~ Ted Gore

NORTH SE SE SW

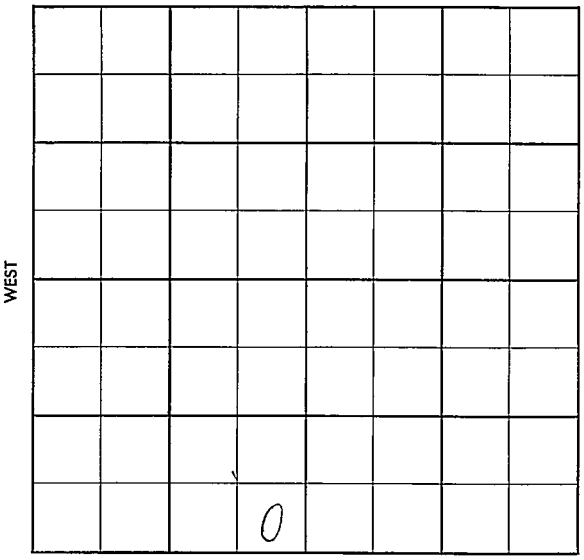

14

FORM 504-3 SUNRAY

Sheridan KANSAS

SEC.	TWP.	R.
15	7 S	28 W

WELL NO. # 1 Watkins FARM

COMPANY ~~Empire Drlg.~~ Ted Gore

CONTRACTOR Co. tools


Wildcat

_____ FT. FROM N. LINE

_____ FT. FROM S. LINE

_____ FT. FROM E. LINE

_____ FT. FROM W. LINE

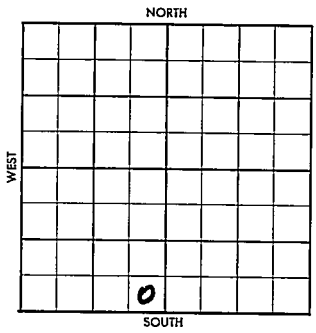

SE SE SW

SDX-1/2 Mile

1957	ELEVATION REPORT
5/29	Location (FR Tkt)

FORM 504-5 SUNRAY

8B-M

WILDCAT

FORM 513 SUNRAY

County Sheridan Elev.

Sec. 15 Twp. 7 Rge. 28W

Company Empire Drlg.

Farm Name Watkins No. 1

TOPS	DEPTH	LOG	DATUM
Anh.			
Tp.			
H.			
Tr.			
Dg.			
Bl.			
L.			
K.C.			
B.K.C.			
Ce.			
C.			
M.			
M.			
K.			
Mz.			
Mo.			
V.			
S.			
S.			
A			
R.			
P€.			
G.			
T.D.			

Loc. in Sec. SE SE SW

Geol.

Contr. Co. Tools

Pool Wildcat

FIRST REPORT

MAY 29 '57

Date Comm.

Location

Co. Lse. No. Sec. T. R.

FORM 515 SUNRAY

CORRECTION

County Sheridan Elev. 2781

Sec. 15 Twp. 7 Rge. 28W

Company ~~Empire Drlg.~~ Ted Gore

Farm Name ~~t.Kins~~ No. 1

Formation	DEPTH	LOG	DATUM
	2493		
		3732	
	3926	3917	
Tr.		3940	
Dg.			
Bl.			
L.	3962	3957	
K.C.			
B.K.C.		4179	
Ce.	4378	4371	
C.			
M.	4496	4492	
M.			
K.			
Mz.			
Mo.			
V.			
S.			
S.			
A			
R.			
Pe.			
G.			
TD	4550	4547	

Loc. in Sec. SE SE SW

Geol.

Contr. Co. Tools

Pool Wildcat

1/2 Mile

ABANDONED

JUN 19 '57

Date Comm. Amerada & Skelly DHM

Location JUN 3 '57 5-30-57 8S/8

282/125 ⌀ 3395 JUN 2 57 ⌀ 4503

JUN 19 '57

D&A