


Section 15 Township 7 Range 21W

Well No. #1 Kenyon

Company Herndon Drlg.

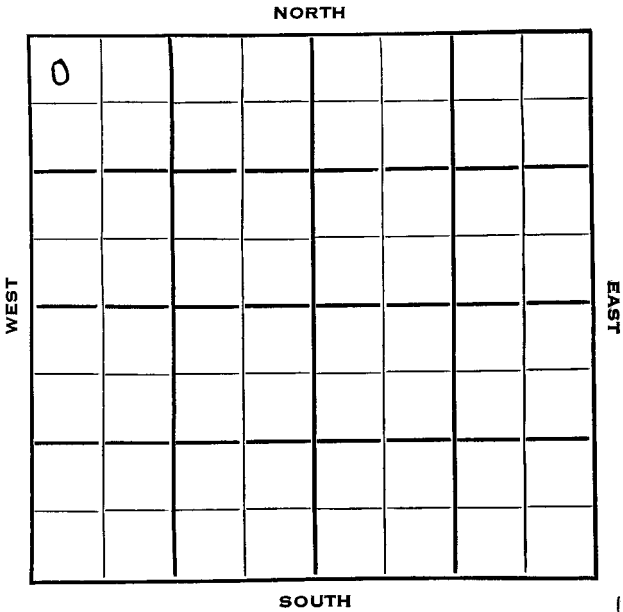

4

Graham

KANSAS

Sec. 15 Twp. 7 R. 21WWell No. #1 Kenyon Farm

Herndon Drlg.

Company

Contractor

Wildcat

330

Ft. from N. Line

Ft. from S. Line


Ft. from E. Line

330

Ft. from W. Line

NW NW NW

CSO - \$5000

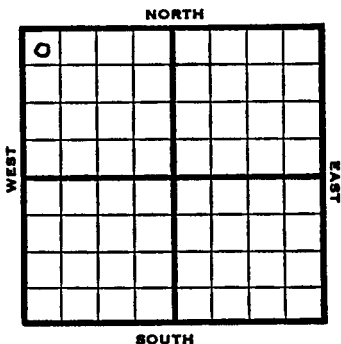

1953

Elev. 2139'

REPORT

4/22

MIM

4/30

8" @ 210

Anhy 1720

Drlg. 3100'

5/6

Spud 4-22-53 D & A TD 3706

8" @ 210 Anhy 1720 Heeb 3359

Dodge 3385 Lans 3402

DST 3422-74 open 1 hr. rec 70' mud

& wtr. SSO 1050# B KC 3592

Cong. 3635 Arb. 3656

DST 3666-73 open 1 hr rec 30' mud

220# TD 3706 D & A

ABANDONED


County Graham State Kansas
 Sec. 15 (Blk.) 7 (Sur.) 21W Map No.
 Operator Harndon Drlg.
 Well No. 1 Farm Kenyon
 Elev. _____ Location NW NW NW

0							

FIRST REPORT

330 Ft. From N Line NW
330 Ft. From W Line Quarter
 1st. Report APR 22 1953
 Completion _____
 Remarks CSO - \$5000
 Spudding Date _____

Drlg. Data Wildcat
M I M

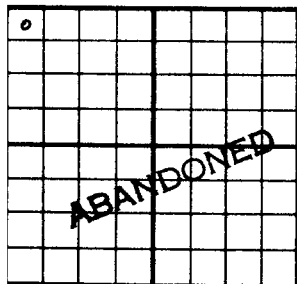County Graham State KansasSec. 15 (Blk.) 7 (Sur.) 21W Map No.Operator Herndon Drlg.Well No. 1 Farm KenyonElev. 2139 Location NW NW NW330 Ft. From N Line NW330 Ft. From W Line Quarter

1st. Report

Completion MAY 6 1953Remarks WildcatSpudding Date 4-22-53Drlg. Data D & A TD 37068" @ 210 Anhy 1720 Heeb. 3 359Dodge 3385 Lans. 3402 DST 3422-74open 1 hr. Rec. 70' mud & wtr. SSO1050# B KC 3592 Cong. 3635Arb. 3656 DST 3666-73 open 1 hr.Rec. 30' mud 220# TD 3706D & A

J. G. McGEHEE