

KANSAS


FORM 51 5M BRIX

Graham County

Section 15 Township 7 Range 22W

Well No. #1 Davis

Company Skelly

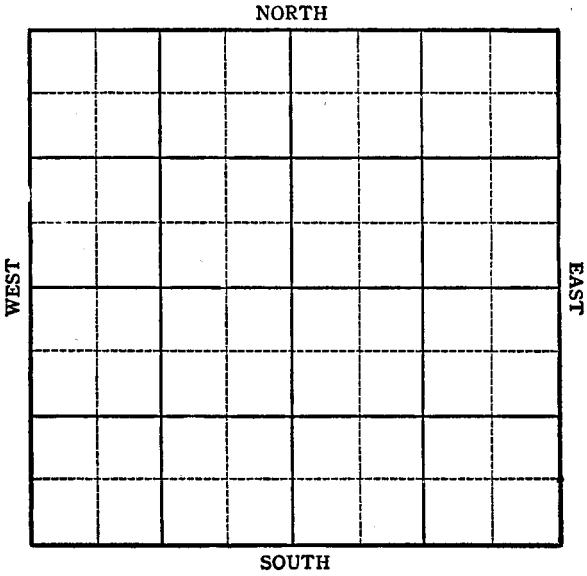

4

Sec. 15 Twp. 7 R. 22W

Well No. #1 Davis Farm

Skelly Company


Wildcat

330 Ft. from N. Line

_____ Ft. from S. Line

_____ Ft. from E. Line

330 Ft. from W. Line

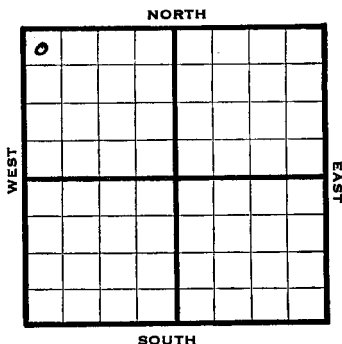

NW/c

944

REPORT

9/6	Loc.
9/13	RUR
9/21	8" @ 442
	Drlg. 3208
9/28	Lans 35 2
	Corr. 3831
	Arb 3841
	3856 TD SD
	5" @ 3842 RUST
10/4	" " " " "
10/11	" " " " "
10/18	Arb. 3839
	5" @ 3840
	TD 3854 Corrected 1500 acid 500
	Butane Show oil gravity less than 16.
10/25	1000 acid Pump 19 oil plus 17% wtr
	in 24 hrs.
11/2	PB 3609 24 shots 3590-98
	7 bluid PH 13 hrs. 98% wtr. PB 3569
	12 shots 3550-54 bail 15 fluid PH
	6 hrs. 2% oil PB 3539-41 shots 3518
	to 3524 Pump 84 oil in 24 hrs.
	1000 acid Pump 177 oil in 9 hrs.

OVER

1944

11/8 Lens 3839
Arb 3839
5" @ 3840 TD 3854
PB 3539
41 shots 3518-24
1000 acid
Pump 518 oil No Water Pot.
Grav. 39.2

COMPLETED

KANSAS Pool Name WildcatMap No. 66 Sec. 15 Twp. 7 R. 22WWell No. 1 DavisSkelly


Company

FIRST REPO

Contractor

TW/C

SECTION PLAT

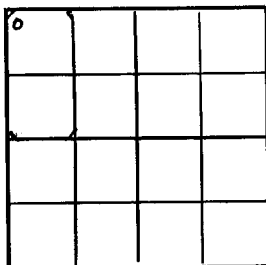330 Ft. from N. Line Ft. from S. Line Ft. from E. Line330 Ft. from W. Line

Graham

RECORD

Location XCased in., ft.Sand Gas Oil Total Depth

Drilling and Remarks:

PRODUCTION

1st 24 hrs. Nat. 1st 24 hrs. after shot Gas Cu. Ft.Dry Hole Abandoned

Date

SEP 6 1944 19

S. J. LEWIS Scout

Pool Name WildcatMap No. 66 Sec. 15 Twp. 7 R. 22WWell No. 1 DavisSkelly CompanyCOMPLETED Contractor

NW/C

SECTION PLAT

0			

330 Ft. from N. Line Ft. from S. Line Ft. from E. Line330 Ft. from W. LineGrahamLocation Rig up

Drilling and Remarks:

Line 2889Core 28895" 28840PS 3589.4 1/2 hrs to 3518 - 241000 acidPump 518 oil No WaterPS

RECORD

Cased in., ft.Sand Gas Oil Total Depth 3854

PRODUCTION

1st 24 hrs. Nat. 1st 24 hrs. after shot Gas Cu. Ft.Dry Hole Abandoned

Date

29th Nov

NOV 8 1944 19

S. J. LEWIS

Scout