


Section 15 Township 7 Range 22-W

Well No. #1 Nichol

Company Frances Oil & Gas

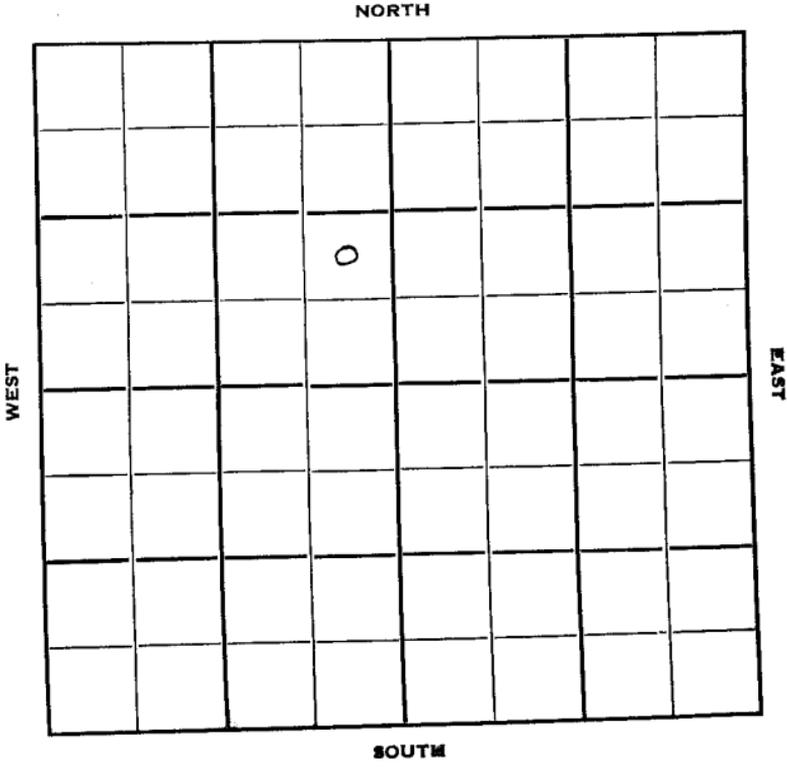

6

Sec. 15 Twp. 7 R. 22W

Well No. #1 Nichol Farm

Francis Oil & Gas Company

Contractor


Ft. from N. Line

990' Ft. from S. Line

330' Ft. from E. Line

Ft. from W. Line

NE SE NW

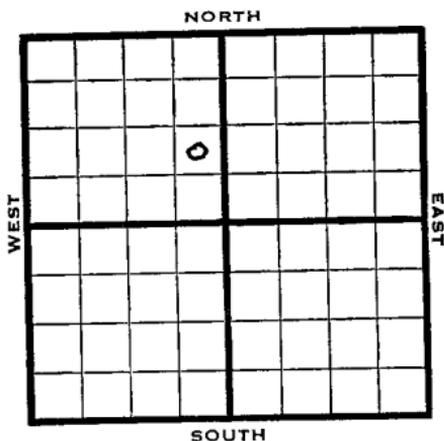

1950

Elev 2255

REPORT

8/9

RUR

8/23

8" @ 226

Anhy 1850-90 Lans 3490

Cong 3760 Arb 3803

DST 3803-07 opn 25 min rec 15' deal

ocm

TD 3830

D&A

ABANDONED



County Graham State Kansas

Sec. 15 (Blk. 7) (Sur. 22W) (Twp.) (Rge.) Map No.

Operator Francis Oil & Gas

Well No. 1 Farm Nichol

Elev. 2255 Location NE SE NW

|                  |  |   |  |  |  |
|------------------|--|---|--|--|--|
|                  |  |   |  |  |  |
|                  |  |   |  |  |  |
|                  |  | 0 |  |  |  |
|                  |  |   |  |  |  |
| <b>ABANDONED</b> |  |   |  |  |  |
|                  |  |   |  |  |  |
|                  |  |   |  |  |  |

990 Ft. From S Line NW

330 Ft. From E Line Quarter

1st. Report \_\_\_\_\_

Completion AUG 23 1950

Remarks \_\_\_\_\_

Spudding Date 8-8-50

Drlg. Data D & A TD 3830

8" @ 226 Anny 1850-90 Lans. 3490

Cong. 3760 Arb. 3803 DST 3803-07

open 25 min. Rec. 15' dead ocm TD 3830  
D & A

J. E. TYRA