

Section 15 Township 7 Range 19W

Well No. #1 Holsman (B)

Company Magnolia

A 10x10 grid map with 'NORTH' at the top, 'SOUTH' at the bottom, 'WEST' on the left, and 'EAST' on the right. A small circle is drawn in the 7th row from the top and 9th column from the left.

9

Rooks

KANSAS

Sec. 15 Twp. 7 R. 19W

Well No. #1 Holsman (B) Farm

Magnolia

Company

Contractor


990 Ft. from N. Line

_____ Ft. from S. Line

330 Ft. from E. Line

_____ Ft. from W. Line

SE NE SE

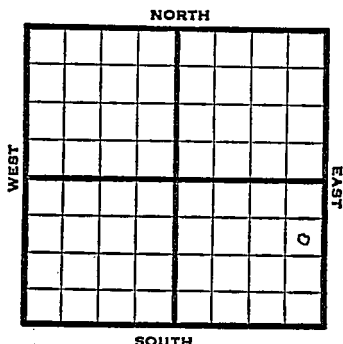

1951

Elev. 1958'

REPORT

11/7

Location

1952

1/16

Spud 11-8-51

Oil Well TD 3537'

10" @ 200'

Heeb. 3116

Tor. 3139

Ians. 3153

Arb. 3423

Gr. 3537

TD 3537 6" @ 3440 PB 3419

24/ 3352-57 2000 A 3 BO 2 BW

4 hr. 4000 A S/ 2 1/2 BO 1/2 BWPH

PB 3346 24/ 3329-37 B/ 10 GO

10 GW 1/2 hr. 4000 A s/ 6 BWPH

3 hr. PB 3326 44/ 3309-20

B/ 5 GO 20 GW 4000 A S/ 7 BOPH

SP 3208 24/ 3194-3200 4000 A

1/2 BWPH CO to 3235 24/ 3212-20

4000 A S/ 2 BWPH W/ SSO 20 hr.

24/ 3162-68 15/ 3154-59 4000 A


S/ 1 1/2 BWPH CO to 3415' 76 BO

7 1/2 BW P/ 72 BOPD P/ 50 BO

8 BWPH

Comp. 72 BOPD

COMPLETED

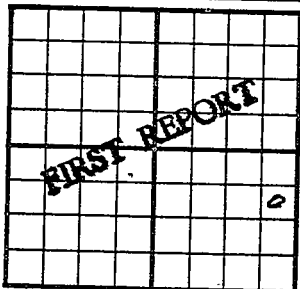County Rock State KansasSec. 15 (Blk. Twp.) 7 (Sur. Rge.) 19W Map No.Operator MagnoliaWell No. 1 Farm Holsman (B)Elev. _____ Location SE NE SE990 Ft. From N Line SE330 Ft. From E Line Quarter1st. Report NOV 7 1951

Completion _____

Remarks _____


Spudding Date _____

Orig. Data _____

Location _____

J. E. TYRA

County Rooks State Kansas
 Sec. 15 (Blk. 7) (Sur. 19W) Map No. 19W
 Operator Magnolia
 Well No. 1 Farm Holsman "B"
 Elev. 1958 Location SE NE SE

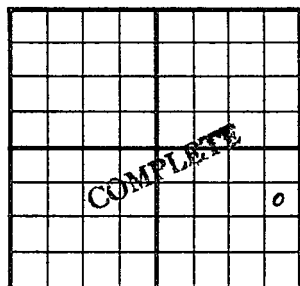

990 Ft. From N Line SE
 330 Ft. From E Line Quarter

Ist. Report

Completion JAN 16 1952

Remarks

Spudding Date 11-8-51

Drlg. Data Oil well TD 3537

10" @ 200 Heeb. 3116 Tor. 3139

Lans. 3153 Arb. 3423 Gr. 3537

TD 3537 6" @ 3440 PB 3419 24/ 3352-

57 2000 A 3 bo 2 bw 4 hr. 4000 A

S/ 2½ bo ½ bwph PB 3346 24/ 3329-37

B/ 10 go 10 gw ½ hr. 4000 A

S/ 6 bwph 3 hr. PB 3326 44/ 3309-20

B/ 5 go 20 gw 4000 A S/ 7 boph

SP 3208 24/ 3194-3200 4000 A

½ bwph CO to 3235 24/ 3212-20

4000 A S/ 2 bwph w/ SSO 20 hr.

24/ 3162-68 15/ 3154-59 4000 A

S/ 1½ bwph CO to 3415 76 bo 7½ bw

J. E. TYRA

Drlg. Data

P/ 72 bopd P/ 50 bo 8 bwph

Comp. 72 bopd

JAN 23 1959

Scout Cards	Y M
Land Small Map	
Land Wall Map	
Tracings	
France Map	
Pierce Map	
Misc.	