

Well No. #2 Clarence Holzman

Company Magnolia

WEST

EAST

SOUTH

16

Sec. 15 Twp. 7 R. 19 W

Well No. # 2 Clarence Holsman Farm

Magnolia Company

Grover Contractor


 Ft. from N. Line

990 Ft. from S. Line

990 Ft. from E. Line

 Ft. from W. Line

NW SE SE

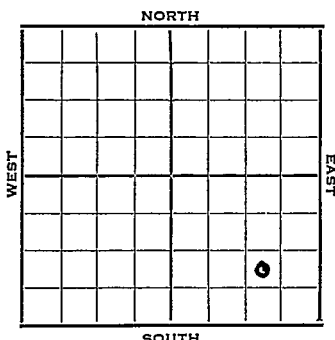

1952 Elev. 1947' REPORT

9/10 Location

9/17 RUR

9/24 8" @ 195
Drl g. 2925'

10/1 Lans 3138,
Drill Pipe stuck 3315

10/8 Recovered pipe, drlg. ahead

10/15 Heeb 3098, Tor 3120, Lans 3137, BKC
3347, Arb 3406
RTD 3408
5" @ 3407, PB 3383, 24/3334-40
1000A S/20 BOPH, Testing


10/22 Spud 9-17-52
OilWell
TD 3408'
8" @ 195
Lans 3137', Heeb. 3098', Tor 3120',
B KC 3347', Arb. 3406
TD 3408'
5" @ 3407'
PB 3383'
24/3334-40, B/10 gm $\frac{1}{2}$ hr., 1000A
S/20 bo 1 hr., S/3 boph PB 3305'
24/3290-98 1000A, S/10 boph 5 hrs.
DP 3383' P/80 bo 8 hr.,
Comp. 195 bopd **COMPLETED**

County Rooks State Kansas
 Sec. 15 (Blk.) 7 (Sur.) 19W Map No.

Operator Magnolia

Well No. 2 Farm Clarence Holzman

Elev. Location NW SE SE

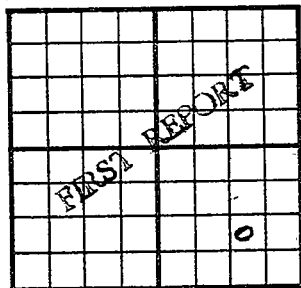

990 Ft. From S Line SE

990 Ft. From E Line Quarter

1st. Report SEP 10 1952

Completion

Remarks


Spudding Date

Drlg. Data Grover

Location

J. G. McGEHEE

County _____ Rooks _____ State _____ Kansas _____
 Sec. 15 (Bk. Twp.) 7 (Sur. Rge.) 19W Map No. _____
 Operator _____ Magnolia _____
 Well No. 2 Farm Clarence Holsman _____
 Elev. 1947 Location NW SE SE _____

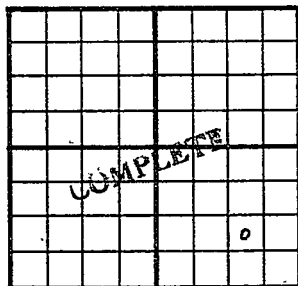

990 Ft. From S Line SE
 990 Ft. From E Line Quarter
 1st. Report _____
 Completion OCT 22 1952
 Remarks Grover Pool

Spudding Date 9-17-52

Drlg. Data Oil well TD 3408
 8" @ 195 Lans. 3137 Heeb. 3098
 Tor. 3120 B KC 3347 Arb. 3406
 TD 3408 5" @ 3407 PB 3383 24/ 3334-40
 B/ 10 gm $\frac{1}{2}$ hr. 1000 A S/ 20 bo 1 hr.
 S/ 3 boph PB 3305 24/ 3290-98 1000 A
 S/ 10 boph 5 hr. DP 3383 P/ 80 bo
 8 hr. Comp. 195 bopd

J. G. McGEHEE