

6-7-16W

*[Handwritten initials]*

TYPE

AFFIDAVIT OF COMPLETION FORM

ACO-1 WELL HISTORY

Compt. \_\_\_\_\_

SIDE ONE

(Rules 82-3-130 and 82-3-107)

DOCKET NO. NP \_\_\_\_\_

This form shall be filed with the Kansas Corporation Commission, 200 Colorado Derby Building, Wichita, Kansas 67202, within ninety (90) days after the completion of a well, regardless of how the well was completed.

FOR INFORMATION REGARDING THE NUMBER OF COPIES TO BE FILED AND APPLICATIONS REQUIRING COPIES OF ACO-1 FORMS SEE PAGE TWO (2), SIDE TWO (2) OF THIS FORM.

F \_\_\_\_\_ Letter requesting confidentiality attached.

C  Attach ONE COPY of EACH wireline log run (i.e. electrical log, sonic log, gamma ray neutron log etc.)\*\*\*Check here if NO logs were run \_\_\_\_\_.

PLEASE FILL IN ALL INFORMATION. IF NOT AVAILABLE, INDICATE. IF INFORMATION LATER BECOMES AVAILABLE, SUBMIT BY LETTER.

LICENSE # 5716 EXPIRATION DATE 6/30/84

OPERATOR S & I Oil Company API NO. 15-163-22,251

ADDRESS Attention: Mr. Dean Ives COUNTY Rooks  
656 Hunton Road

El Dorado, KS 67042 FIELD wildcat

\*\* CONTACT PERSON Mr. Dean Ives PROD. FORMATION \_\_\_\_\_  
PHONE 316-321-3262 \_\_\_\_\_ Indicate if new pay.

PURCHASER \_\_\_\_\_ LEASE Fenton

ADDRESS \_\_\_\_\_ WELL NO. #1

DRILLING Emphasis Oil Operations WELL LOCATION SW/4  
1514 Ft. from N SW/4 Line and

CONTRACTOR ADDRESS P. O. Box 506 212 Ft. from W SW/4 Line of  
Russell, KS 67665 1350 the SW (Qtr.) SEC 6 TWP 7S RGE 16 (W)

PLUGGING Emphasis Oil Operations

CONTRACTOR ADDRESS P. O. Box 506

Russell, KS 67665

TOTAL DEPTH 3410' R.T.D. PBTD \_\_\_\_\_

SPUD DATE 2/3/84 DATE COMPLETED 2/10/84

ELEV: GR 1847' DF 1849' KB 1852'

DRILLED WITH ~~MOBILEX~~ (ROTARY) ~~MOBILEX~~ TOOLS.

DOCKET NO. OF DISPOSAL OR REPRESSURING WELL BEING USED TO DISPOSE OF WATER FROM THIS LEASE \_\_\_\_\_


Amount of surface pipe set and cemented 1260' DV Tool Used? \_\_\_\_\_

TYPE OF COMPLETION THIS AFFIDAVIT APPLIES TO: (Circle ONE) - Oil, Shut-in Gas, Gas, Dry, Disposal, Injection, Temporarily Abandoned. If OWWO, indicate type of re-completion \_\_\_\_\_. Other completion \_\_\_\_\_. NGPA filing \_\_\_\_\_

ALL REQUIREMENTS OF THE STATUTES, RULES AND REGULATIONS PROMULGATED TO REGULATE THE OIL AND GAS INDUSTRY HAVE BEEN FULLY COMPLIED WITH.

A F F I D A V I T

that: H. DEAN Ives, being of lawful age, hereby certifies

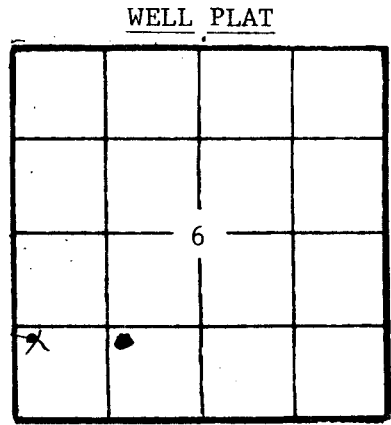

(Office Use Only)  
KCC \_\_\_\_\_  
KGS \_\_\_\_\_  
SWD/REP \_\_\_\_\_  
PLG. \_\_\_\_\_  
NGPA \_\_\_\_\_

Side TWO OPERATOR S & I Oil Company LEASE NAME Fenton SEC 6 TWP 7S RGE 16 (W) WELL NO 1

FILL IN WELL INFORMATION AS REQUIRED;

Show all important zones of porosity and contents thereof; cored intervals, and all drill-stem tests, including depth interval tested, cushion used, time tool open, flowing and shut-in pressures, and recoveries.

Show Geological markers, logs run, or other Descriptive information.

Formation description, contents, etc. Top Bottom Name Depth

Check if no Drill Stem Tests Run.  
 Check if samples sent Geological Survey.

*Attached Geologist Report*

*Drill stem test*

*3025 3072*

*Recovered 10' mud*

*30/30/30/30*

*25#-286#*

*25#-23# 176#*

If additional space is needed use Page 2

Report of all strings set— surface, intermediate, production, etc.

CASING RECORD (New) or (Used)

Purpose of string	Size hole drilled	Size casing set (in O.D.)	Weight lbs/ft.	Setting depth	Type cement	Sacks	Type and percent additives
Surface	12 1/4"	8 5/8"		1260'	60/40 Poz.	400	

LINER RECORD

PERFORATION RECORD

Top, ft.	Bottom, ft.	Sacks cement	Shots per ft.	Size & type	Depth interval

TUBING RECORD

Size	Setting depth	Pecker set at

6-7-16W  
P/  
And



EMPHASIS OIL OPERATIONS

P. O. BOX 506  
RUSSELL, KS 67665

DRILLERS LOG

OPERATOR: S & I Oil Company  
656 Hunton Road  
El Dorado, KS 67042

CONTRACTOR: Emphasis Oil Operations  
P. O. Box 506  
Russell, KS 67665

LEASE: Fenton WELL: #1

LOCATION: SW/4  
Section 6-7S-16W  
Rooks County, KS

Rotary Total Depth: 3410'

Log Total Depth: 3404'

Commenced: 2/3/84

Elevation: 1852' K.B.

Date Completed: 2/10/84

Casing: 8 5/8" @ 1260' with 400 sacks cement

Status: Dry Hole


DEPTHS & FORMATIONS

(All measurements from K.B.)

Top Soil & Sand	28'	Shale	2741'
Sand & Shale	945'	Lime & Shale	3291'
Shale	1250'	Lime & Chert (R.T.D.)	3410'
Anhydrite	1283'		

STATE OF KANSAS )  
                          ) ss:  
COUNTY OF RUSSELL)

Joe K. Branum, of Emphasis Oil Operations, states that the above and foregoing is a true and correct log of the above captioned well, to the best of his knowledge.

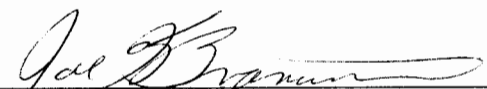  
\_\_\_\_\_  
Joe K. Branum