

Graham


FORM 51 5M BRIX

KANSAS

Section 16 Township 7 Range 22W

Well No. #1 M. E. Worcester

Company Sinclair-Prairie

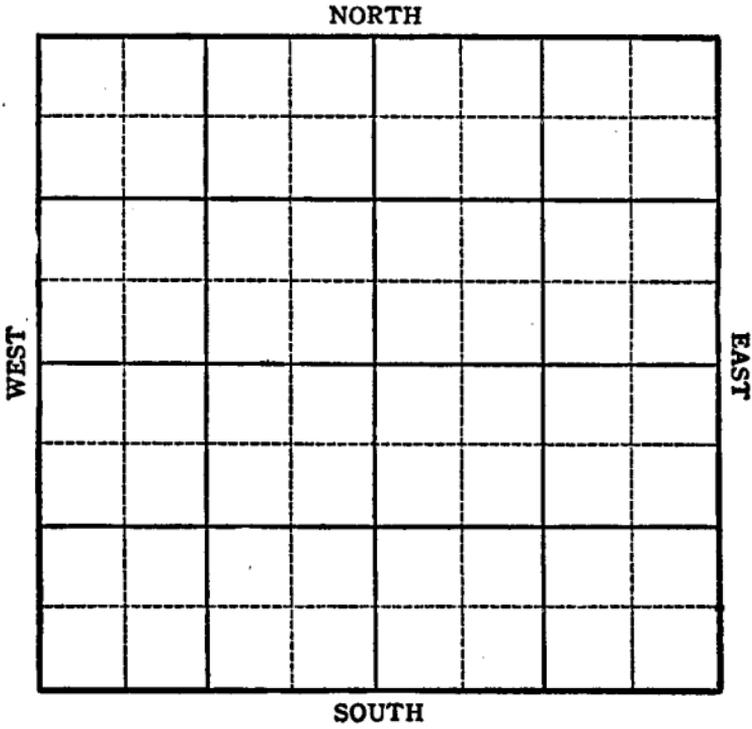

Sec. 16 Twp. 7 R. 22W

Well No. 1 M. E. Worcester Farm _____

Sinclair-Prairie

Company _____

NW NE NE


NORTH

330 Ft. from N. Line

_____ Ft. from S. Line

_____ Ft. from E. Line

990 Ft. from W. Line

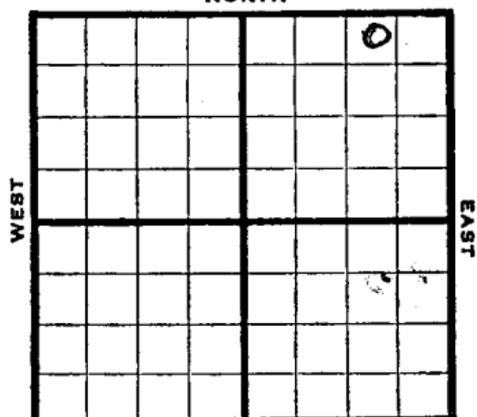

Alda

SOUTH

1944 R E P O R T

11/22 Derrick
1/29 RUR
12/6 13" @ 42'
Drlg. 1060'
2/14 9" @ 1273'
Drlg. 2380'
2/21 Drlg. 3465
/29 Topeka 3315
Lans 3542
Stains 2560-2565, 2575-2580, 2600-2605
2640-2645, 2650-2655, 2670-2675,
Bkc 3755
Sta ns 3790-3795,
Cong 3825
Arb 3868-3877 TD
5" @ 3868
Must
1945
1/3 "
1/10 Arb 3858 corrected
5" @ 3858 TD 3868
1000 acid
1/17 Water 3890
TD 3893 PB
1/24 Arb. 3858
5" @ 3858
TD 3893 ABANDONED

Pool Name Alda

Map No. 66 Sec. 16 Twp. 7 R. 22W

Well No. 1 M. E. Worcester

Sinclair-Prairie Company

FIRST REPORT Contractor

NW NE NE


SECTION PLAT

330 Ft. from N. Line

_____ Ft. from S. Line

_____ Ft. from E. Line

990 Ft. from W. Line

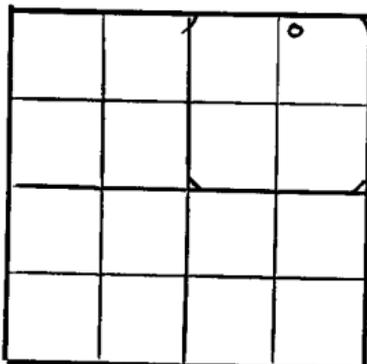

Graham

RECORD

Location _____

Rig up _____

Drilling and Remarks:
derrick

Cased _____ in., _____ ft.

Sand _____

Gas _____

Oil _____

Total Depth _____

PRODUCTION

1st 24 hrs. Nat. _____

1st 24 hrs. after shot _____

Gas _____ Cu. Ft.

Dry Hole _____

Abandoned _____

Date

NOV 22 1944 19 _____

S. J. LEWIS Scout

Pool Name AlfaMap No. 5-36 Sec. 16 Twp. 7 R. 22WWell No. 1 M. E. WorcesterSinclair-Prairie

Company

ABANDONED

Contractor

NW NE NE

SECTION PLAT

330 Ft. from N. Line

Ft. from S. Line

Ft. from E. Line

990 Ft. from W. Line

			6

Graham

Location

Rig up

Drilling and Remarks:

CU X 3858
5 @ 3858

RECORD

Cased _____ in., _____ ft.

Sand _____

Gas _____

Oil _____

Total Depth 3858

PRODUCTION

1st 24 hrs. Nat. _____

1st 24 hrs. after shot _____

Gas _____ Cu. Ft.

Dry Hole _____

Abandoned _____

Date

JAN 24 1945 19

S. J. LEWIS Scout