


Section 16 Township 7 Range 22 W

Well No. # 2 Worcester "A"

Company Murfin Drlg.

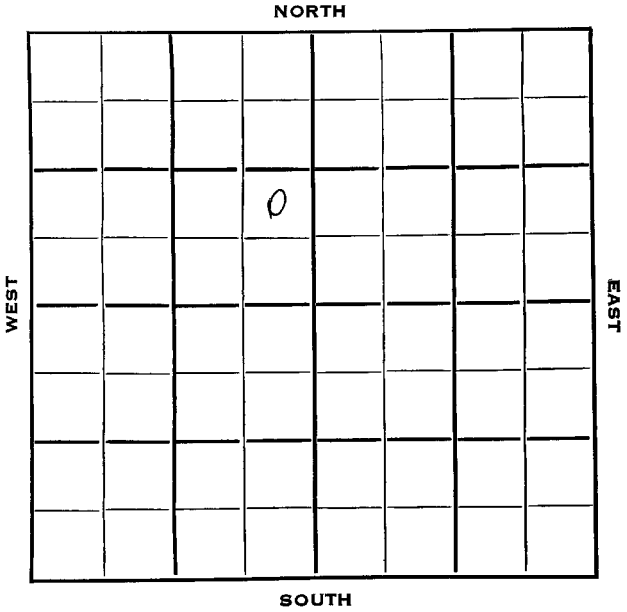

6

Graham

KANSAS

SEC.	TWP.	R.
16	7	22 W ✓

WELL NO.

2 Worcester "A"

FARM

COMPANY

Murfin Drlg.

CONTRACTOR

Murfin Drlg.


_____ Ft. from N. Line

990 _____ Ft. from S. Line

330 _____ Ft. from E. Line

_____ Ft. from W. Line

NE SE NW

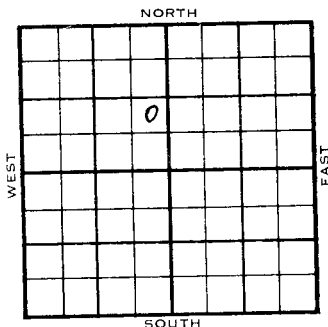

	ELEVATION	REPORT
1953	2328'	

12/22

MIR

1954
1/6

8" @ 151 Top 3322 Heeb 3512

Tor 3533 Lans 3551

DST 3594-? 2460' SW, 1250#

DST 3625-37, 34 mins, 525' SW

1000#

Drlg. 3875'

1/13

Spud 12-22-53

D & A

TD 3890'

8" @ 151'

Anhy 1945', Top 3322, Heeb 3512',

Tor 3533, Lans 3551'

DST 3594'-? rec 2460' sw 1250#

DST 3625'-37' opn 39 min, rec 525' sw

1000# B KC 3755', Cong 3860'

TD 3890'

D & A

ABANDONED

