

Sec. 16 Twp. 7 R. 22W

Well No. #1 Fabricius Farm

Murfin Drlg. Company

Murfin Drlg. Contractor


330 Ft. from N. Line

Ft. from S. Line

Ft. from E. Line

330 Ft. from W. Line

NW NW SW

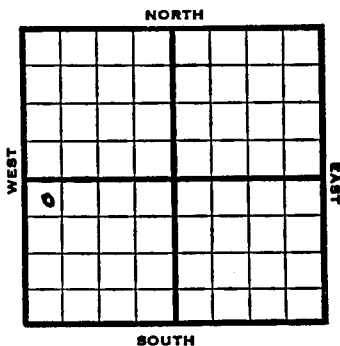

1952 Elev. 2332' REPORT

12/23 Location

- 1/1 Location
- 1/8 ø 2880
- 1/15 Heeb 3518, Toronto 3542, lans 3556'
Sho oil 3594-98
DST 3628-40, opn 1/2 hr., rec. 262' wtr,
Drlg. ahead
- 1/22 DST 3683-91, 1 hr, 12' M 700#
DST 3708-20, 1/2 hr, 6' M 550#
DST 3735-47, 1 hr, 153' oil plus 30'
O & WCM 900# Cong. 3858'
RTD 3895' 5" @ 3780'
- 1/29 Bad cement jog - re-cement
- 2/5 CO 24/3743-46 S/1 BOPH 2 hrs.
1000 A S/9 BOPH 4 hrs. G. 24
- 2/12 NR
- 2/19 NR
- 2/26 NR

OVER

#1 Fabricius

1953
3/4

Spud 12-29-52

D&A

TD 3895

8" @ 190

Heeb 3518, Tor 3542, Lans

3556, SO 3594-98

DST 3628-40, opn $\frac{1}{2}$ hr., rec.

262' wtr., 1025#

DST 3683-91, opn 1 hr., rec.

12' mud, 700#

DST 3708-20, opn $\frac{1}{2}$ hr., rec.

6' mud, 550#

DST 3735-47, opn 1 hr., rec.

153' oil, 30' o&wcm, 900#

Cong 3858

TD 3895

5" @ 3780 CO

24/3743-46, S/1 boph 2 hrs.

S/9 bwph 1 boph 1000/A

D&A

ABANDONED

