


Graham

KANSAS

Section 16 Township 7 Range 22W

Well No. 2 Worcester 'B'

Company Murfin Drlg.

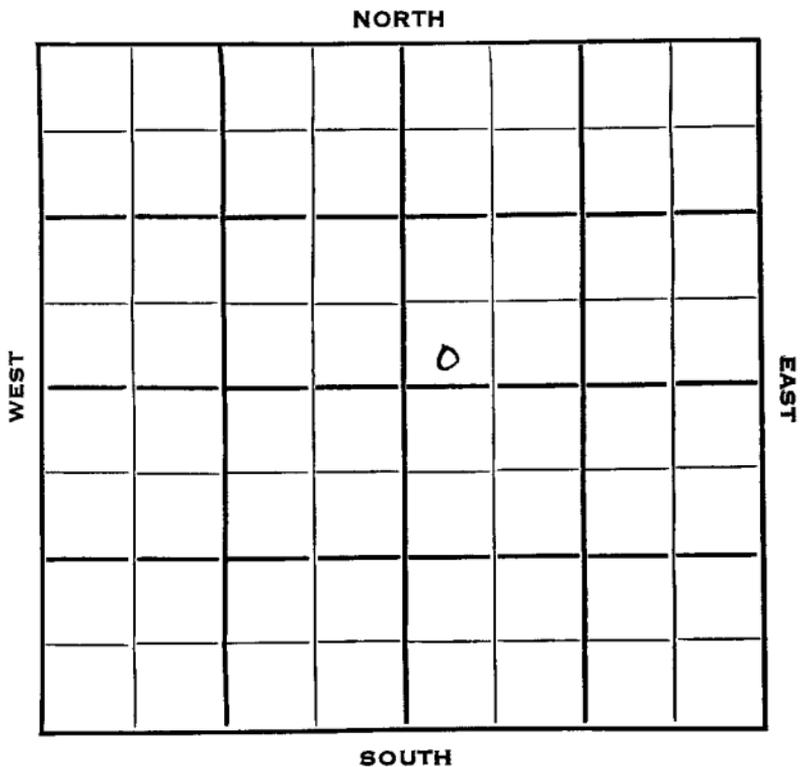

7



Sec. 16 Twp. 7 R. 22W
 Well No. #1 Worcester "B"
~~#2 Worcester~~ Farm

Murfin Drlg. Company


Murfin Contractor

Ft. from N. Line

330 Ft. from S. Line

Ft. from E. Line

330 Ft. from W. Line

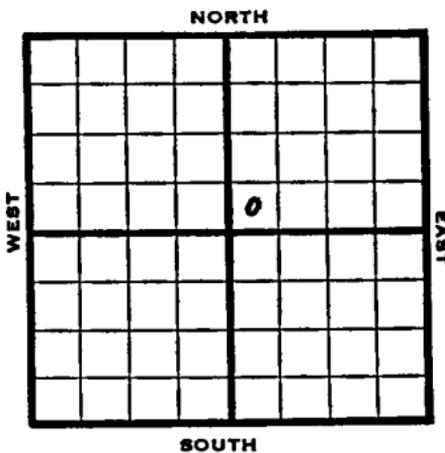

SW SW NE

1953 Elev. 2332' REPORT

- 1/21 Spud 1-17-53
8" @ 188
Drlg. 1766
- 1/29 Tite Hole
- 2/5 Pipe set
- 2/12 Top 3320' Heeb 3517' Tor 3539'
Lans. 3554'
DST 3548-65, 1 hr, 70' gas, 110' muddy gassy oil 500#
DST 3625-35, 1 hr, 250' gas, 50' free oil, 105' muddy gassy oil 1000#
RTD 3885
DST 3706-20, 1 hr, 1000' gas, 1805' clean oil, 5' muddy oil 950#
5" @ 3885'
- 2/19 POP
- 2/26 "
- 3/3 Spud 1-17-53
Oil Well
TD 3885
8" @ 188
Top 3320, Heeb 3517, Tor 3539
DST 3523-50, opn 1 hr.,
Lans 3554
DST 3548-65, opn 1 hr., rec.
70' gas, 110' muddy, gassy oil
500#

OVER

#1 Worcester "B"
(Information Brought Forward)

1953
3/4

DST 3625-35, opn 1 hr., rec.
250' gas, 50' free oil, 105'
muddy, gassy oil 1000#

TD 3885

5" @ 3885

DST 3706-20, opn 1 hr., rec.
1000' gas, 1805' clean oil, 5'
muddy oil, 950#

Cong 3848

Perf/3706-20, S/5 boph

Comp. 80 bopd

COMPLETED

KANSAS

Map No. _____ Sec. 16 Twp. 7 R. 22W

Well No. 1 Worcester "B"

Murfin Drlg. Company

CORRECTION Contractor

SW SW NE

SECTION PLAT

_____ Ft. from N. Line

330 Ft. from S. Line

_____ Ft. from E. Line

330 Ft. from W. Line

		6	

Graham County

Location _____

Rig up _____

Drilling and Remarks:

Reported
#2 Worcester

RECORD

Cased _____ in., _____ ft.

Sand _____

Gas _____

Oil _____

Total Depth _____

PRODUCTION

1st 24 hrs. Nat. _____

1st 24 hrs. after shot _____

Gas _____ Cu. Ft.

Dry Hole _____

Abandoned _____

Date

FEB 25 1953 19

J. G. McGEHEE

Scout

