

Section 16 Township 7 Range 19WWell No. #1 McCauleyCompany Stearns Drlg.

NORTH

				0			

SOUTH

WEST

EAST

2

Rooke

KANSAS

Sec. 16 Twp. 7 R. 19W

Well No. #1 McCauley Farm

Stearns Drlg.

Company

Contractor

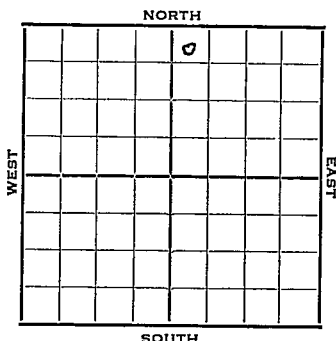
330' Ft. from N. Line

Ft. from S. Line

Ft. from E. Line

330' Ft. from W. Line

NW NW NE



1952

Elev. 1939'

REPORT

2/16

8" @ 198

Anhy 1435

Drlg. 2200'

3/5

5" @ 3445' WOC

3/12

34/3317-24' 5500 A

S/350' oil plus 350' wtr. 20 mins.
PB to ?

3/19

Spud 2-16-52

D&A TD 3446

8" @ 198

Anhy 1435

Top. 2890

DST 3064-77 open 1hr. rec. 74' SOCM

Heeb. 3092 Lans. 3134

DST 3306-25 open 45 min. rec. 7' SOCM

DST 3390-3405 open 45 min. rec. 6' mud
& SO Arb. 3414

DST 3414-22 open 1 hr. rec. 25' drlg.

mud & SSO TD 3446 5" @ 3445

34/ 3317-24 5500 A S/ 350' oil

350' wtr. 20 min. CO to 3435

21/ 3426-33 5500 A S/ 14 bwph

PB 3426 3000 A S/ 3 bwph SP 3410

12/ 3402-06 12/ 3398-3402 B/ 3 bwph

3 hr. SP 3330 23/ 3308-16

23/ 3288-92 dry 3000 A B/ 10 goph

15 gw PB 3260 12/ 3246-50

18/ 3234-40 12/ 3228-32 B/ 3 1/2 bf

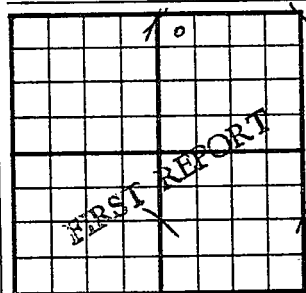
4 hr. 4000 A S/ 60' oil dec.

OVER

1952

3/19 PB 3197 30/ 3168-78 24/ 3133-41
dry. PB 3150 S/ 5 bwph S/
3 $\frac{1}{2}$ bwph PB 3126 23/ 3064-72
S/ 3 bwph SCUM oil CO to 3100
45/ 3064-92 1000 A S/ 1 bfph
D&A

ABANDONED

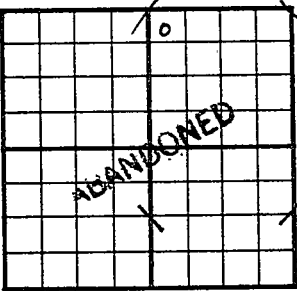
County _____ Rocks _____ State KansasSec. 16 (Blk. Twp.) 7 (Sur. Rge.) 19W Map No. _____Operator Stearns Drig.Well No. 1 Farm McCauleyElev. _____ Location NW NW NE330 Ft. From II Line NE330 Ft. From II Line Quarter1st. Report FEB 20 1952

Completion _____

Remarks _____

Spudding Date 2-16-52Drig. Data SE Locust Grove Pool8" @ 198 Any 1435 drig. 2200

J. G. McGEHEE

County	Rooks	State	Kansas
Sec. 16	(Blk. Twp.) 7	(Sur. Rge.) 19W	Map No.
Operator Stearns Drlg.			
Well No. 1 Farm McCauley			
Elev. 1939	Location NW NW NE		
		330 Ft. From N Line NE	
		330 Ft. From W Line Quarter	
		1st. Report	
		Completion MAR 19 1952	
		Remarks SE Locust Grove Poo.	
		Spudding Date 2-16-52	
Drlg. Data D & A		TD 3446	

8" @ 198 Anhy 1435 Top. 2890

DST 3064-77 open 1 hr. Rec. 74' socm

Heeb. 3092 Lans. 3134 DST 3306-25

open 45 min. Rec. 7' socm DST 3390-3405

open 45 min. Rec. 6' mud & SO Arb. 3414

DST 3414-22 open 1 hr. Rec. 25' drlg.

mud & SSO TD 3446 5" @ 3445

34/ 3317-24 5500 A S/ 350' oil 350'

water 20 min. CO to 3435 21/ 3426-33

5500 A S/ 14 bwph PB 3426 3000 A

S/ 3 bwph SP 3410 12/ 3402-06

12/ 3398-3402 B/ 3 bwph 3 hr. SP 3330

23/ 3308-16 23/ 3288-92 dry 3000 A

B/ 10 goph 15 gw PB 3260 12/ 3246-50

J. G. McGEHEE

Drlg. Data

18/ 3234-40 12/ 3228-32 B/ $3\frac{1}{2}$ bf 4 hr.

4000 A S/ 60' oil dec. PB 3197

30/ 3168-78 24/ 3133-41 dry. PB 3150

S/ 5 bwph S/ $3\frac{1}{2}$ bwph PB 3126

23/ 3064-72 S/ 3 bwph scum oil CO to

3100 45/ 3064-92 1000 A S/ 1 bfph

D & A

MAR 25 1962

