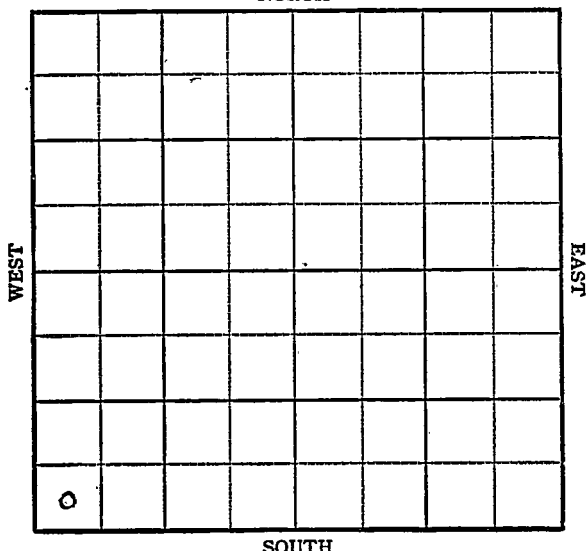


KANSAS

Rooks

Section 16 Township 7 Range 19WWell No. #1 SchrubenCompany Sam PackWildcat
NORTH

13

KANSAS

Rooks

HOT FILE

Sec. 16 Twp. 7 R. 19W ✓

Well No. #1 Schruben Farm

Sam Pack

Company

Wildcat


 Ft. from N. Line

330' Ft. from S. Line

 Ft. from E. Line

330' Ft. from W. Line

SW/C

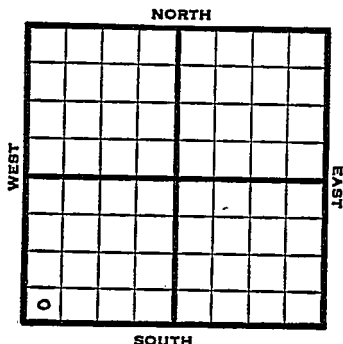

1948

6/15/1985

REPORT

12/15

RUR

12/22

8" @ 186'

Lansing 3166'

Drlg 3200'

12/29

Arbuckle 3433'

TD 3441

5" @ 3436'

1/5

" "

1/12

3447-3500 acid

TD 3471 sw & 8 WPH

1/19

TD 3471'

Arb. 3433'

9000 acid

Aband.

ABANDONED

*3433
1985
1448*

Kansas

19W

Map No. _____ Sec. 16 Twp. 7 R. _____

Well No. 1 Schruben _____

Sam Pack _____ Company _____

FIRST REPORT

Contractor _____

SW/C

SECTION PLAT

_____ Ft. from N. Line

330 _____ Ft. from S. Line

_____ Ft. from E. Line

330 _____ Ft. from W. Line

Rooks County

Location _____

Rig up _____

Drilling and Remarks:

R U R

RECORD

Cased _____ in., _____ ft.

Sand _____

Gas _____

Oil _____

Total Depth _____

PRODUCTION

1st 24 hrs. Nat. _____

1st 24 hrs. after shot _____

Gas _____ Cu. Ft.

Dry Hole _____

Abandoned _____

Date

DEC 15 1948

19

S. J. LEWIS

Scout

Kansas

Map No. 65 Sec. 16 Twp. 7 R. 19WWell No. 1 Schruben


Sam Pack

Company

ABANDONED

Contractor

SW/C

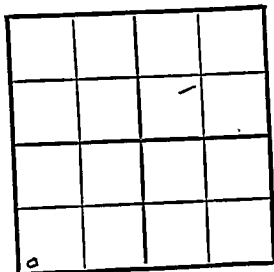E11985
SECTION PLAT

Ft. from N. Line

330

Ft. from S. Line

Ft. from E. Line

330

Ft. from W. Line

Rooks County

Location

Rig up

Drilling and Remarks:

*On 83433**9000 acid*

RECORD

Cased _____ in., _____ ft.

Sand _____

Gas _____

Oil _____

Total Depth *3471*

PRODUCTION

1st 24 hrs. Nat. _____

1st 24 hrs. after shot _____

Gas _____ Cu. Ft.

Dry Hole _____

Abandoned _____

Date

JAN 19 1949

19

S. J. LEWIS

Scout