

18-7-17W<sup>2nd</sup>

TYPE

AFFIDAVIT OF COMPLETION FORM

ACO-1 WELL HISTORY

Compt. P1

SIDE ONE

State Geological Survey

WICHITA BRANCH

(Rules 82-3-130 and 82-3-107)

This form shall be filed with the Kansas Corporation Commission, 200 Colorado Derby Building, Wichita, Kansas 67202, within ninety (90) days after the completion of a well, regardless of how the well was completed.

FOR INFORMATION REGARDING THE NUMBER OF COPIES TO BE FILED AND APPLICATIONS REQUIRING COPIES OF ACO-1 FORMS SEE PAGE TWO (2), SIDE TWO (2) OF THIS FORM.

F Letter requesting confidentiality attached.

C  Attach ONE COPY of EACH wireline log run (i.e. electrical log, sonic log, gamma ray neutron log etc.)\*\*\*Check here if NO logs were run \_\_\_\_\_.

PLEASE FILL IN ALL INFORMATION. IF NOT AVAILABLE, INDICATE. IF INFORMATION LATER BECOMES AVAILABLE, SUBMIT BY LETTER.

LICENSE # 6656 EXPIRATION DATE 6-30-84

OPERATOR American Lariat, Inc. API NO. 15-163-22016

ADDRESS Box 936 COUNTY Rooks

Hays, KS 67601 FIELD Riffe

\*\* CONTACT PERSON G. Marleau PROD. FORMATION Arbuckle

PHONE 913-625-8190

PURCHASER KOCH OIL COMPANY LEASE Miller

ADDRESS Box 2256 WELL NO. 1

Wichita, KS 67201 WELL LOCATION SE, SW, NW


DRILLING CONTRACTOR Lawbanco Drilling, Inc. 1320 Ft. from West Line and

ADDRESS Box 289 2310 Ft. from North Line of  
Natoma, KS 67651 the NW (Qtr.) SEC 18 TWP 7S RGE 17(W).

PLUGGING CONTRACTOR ADDRESS \_\_\_\_\_

WELL PLAT

(Office Use Only)

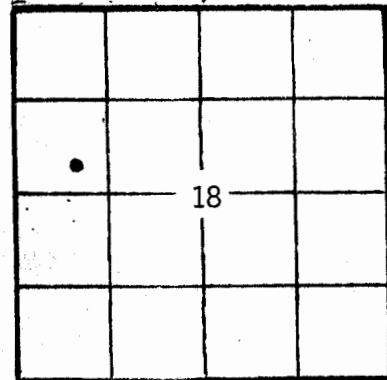

KCC   
KGS

SWD/REP \_\_\_\_\_  
PLG. \_\_\_\_\_

NGPA \_\_\_\_\_

TOTAL DEPTH 3357' PBD 3332'

SPUD DATE 10-6-83 DATE COMPLETED 1-11-83

ELEV: GR 1838' DF \_\_\_\_\_ KB 1843'

DRILLED WITH (CABLE) (ROTARY) (AIR) TOOLS \_\_\_\_\_

DOCKET NO. OF DISPOSAL OR REPRESSURING WELL BEING USED TO DISPOSE OF WATER FROM THIS LEASE NA

Amount of surface pipe set and cemented 1265' DV Tool Used? No

TYPE OF COMPLETION THIS AFFIDAVIT APPLIES TO: (Circle ONE) - Oil Shut-in Gas, Gas, Dry, Disposal, Injection, Temporarily Abandoned. If OWWO, indicate type of re-completion \_\_\_\_\_ . Other completion \_\_\_\_\_ . NGPA filing \_\_\_\_\_ .

ALL REQUIREMENTS OF THE STATUTES, RULES AND REGULATIONS PROMULGATED TO REGULATE THE OIL AND GAS INDUSTRY HAVE BEEN FULLY COMPLIED WITH.

A F F I D A V I T

G. Marleau, being of lawful age, hereby certifies that:

I am the Affiant, and I am familiar with the contents of the foregoing Affidavit. The statements and allegations contained therein are true and correct.

W-27-81  
SIDE TWO

OPERATOR American Lariat, Inc. LEASE Miller #1 SEC. 18 TWP. 7 RGE. 17 (W)

FILL IN WELL INFORMATION AS REQUIRED:

WELL NO. 1

FORMATION DESCRIPTION, CONTENTS, ETC.		TOP	BOTTOM	NAME	DEPTH
X Check if no Drill Stem Tests Run. Check if samples sent to Geological Survey					
0 to 590	Sand and shale			Anhydrite	1265' +57'
590 to 1264	Shale and sand			Topeka	2776' -93'
1263 to 1298	Anhydrite			Heebner	2986' -114'
1298 to 2213	Sand and shale			Toronto	3010' -116'
2213 to 2512	Shale and sand			Lans. K.C.	3030' -118'
2512 to 2900	Shale and lime			Base K.C.	3256' -141'
2900 to 3347	Shale and lime			Arbuckle	3353' -151'
3347 to 3357	Shale and lime RTD			RTD	3357' -151'

ACID, FRACTURE, SHOT, CEMENT SQUEEZE RECORD

Amount and kind of material used		Depth interval treated
None		
Date of first production 10-28-83		Producing method (flowing, pumping, gas lift, etc.) Pumping
Estimated Production -I.P. 40 bbls.		Gravity 23
Disposition of gas (vented, used on lease or sold) None		Water 30% Gas-oil ratio Perforations OH 3356' = 3358'

Report of all strings set — surface, intermediate, production, etc. CASING RECORD (New) or (Used)

Purpose of string	Size hole drilled	Size casing set (in. O.D.)	Weight lbs/ft.	Setting depth	Type cement	Spcks	Type and percent additives
Surface	12 1/4"	8 5/8"	24#	1265'	60-40 Poz-mix	275	2% Gel, 3% CaCl
					Common	200	2% Gel, 3% CaCl
Production	7 7/8"	5 1/2"	14#	3356'	Common	130	4% Gel, 6% Gypse 75% CaCl

LINER RECORD			PERFORATION RECORD		
Top, ft.	Bottom, ft.	Spcks cement	Shots per ft.	Size & type	Depth interval
None			None		
TUBING RECORD					
Size	Setting depth	Pecker set of			
2 7/8"	3357'	NIL			