

~~KANON~~

Section 17 Township 7 Range 18W

Well No. 1 Kollman

Company Salina Drlg.

NORTH

WEST

EAST

SOUTH

5

Sec. 17 Twp. 7 R. 18 W

Well No. # 1 Kollman Farm

Salina Drlg. Company

Wildcat Contractor


 Ft. from N. Line

330 Ft. from S. Line

 Ft. from E. Line

330 Ft. from W. Line

SW SW NW

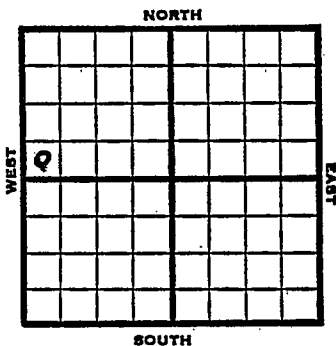

1953

Heeb. 1962' REPORT

2/4

Location

2/12

8" @ 210
Drlg. 980'

2/19

Top 2916' - Heeb 3093' Doug 3135'
Lans. 3146' B KC
Drlg. 3436'

2/25

Spud 2-7-53
D & A TD 3566 8" @ .210
Top 2916 Heeb 3093 Doug 3135
Lans 3146 B KC 3390
DST 3268-82 open 1/2 hr. rec 5' SOCM
Arb. 3466 TD 3566 D & A

ABANDONED.

County _____ Rocks _____ State Kansas

Sec. 17 (Blk. 7) (Sur. 18W) (Twp. 7) (Rge. 18W) Map No. _____

Operator Salina Drlg.

Well No. 1 Farm Kollman

Elev. 1962 Location SW SW NW

330 Ft. From S Line NW

330 Ft. From W Line Quarter

Ist. Report _____

Completion FEB 25 1953

Remarks Wildcat

Spudding Date 2-7-53

Drlg. Data D & A TD 3566

8" @ 210 Top. 2916 Heeb. 3093

Doug. 3135 Lans. 3146 B KC 3390

DST 3268-82 open $\frac{1}{2}$ hr. Rec. 5' socm

Arb. 3466 TD 3566

D & A

J. G. McGEHEE