

Graham


KANSAS

SECTION 18 TOWNSHIP 7 RANGE 25 W

WELL NO. #2 Brandt

COMPANY Brooks Hall & J-S-F

NORTH

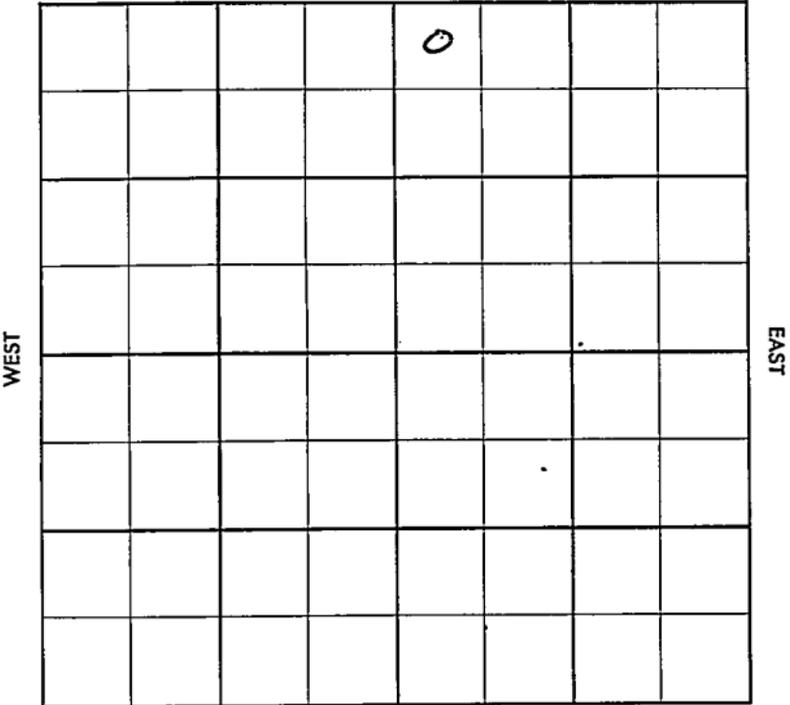

SOUTH

2

~~###~~

2-23 Putting on pump

###

2-1 No report

3-8 "

3-15 P/ 70 bo 24 hrs.

3-22 No report

3-29 "

4-4 Comp. 262 bopd
TD 4175'

COMPLETED

County Grayam Elev. _____
 Sec. 18 Twp. 7 Rge. 25W
 Company Brooks Hall & J-S-F
 FarmName Brandt No. 2

| TOPS | DEPTH | LOG | DATUM | Loc. in Sec. |
|--------|-------|-----|-------|-------------------|
| Anh. | | | | NW NW NE |
| TP. | | | | |
| H. | | | | |
| Tr. | | | | |
| Dg. | | | | |
| Bl. | | | | |
| L. | | | | Geol. _____ |
| K.C. | | | | |
| B.K.C. | | | | Contr. _____ |
| Ce. | | | | <u>J-S-F</u> |
| C. | | | | |
| M. | | | | Pool _____ |
| M. | | | | <u>Huntington</u> |
| K. | | | | |
| Mz. | | | | |
| Ma. | | | | |
| V. | | | | |
| S. | | | | |
| S. | | | | |
| A. | | | | |
| R. | | | | |
| PE. | | | | |
| G. | | | | |
| T.D. | | | | |

1/2 mile
FIRST REPORT
 JAN 11 1956

Date Comm. 1-9-56

Co.

Lse.

No.

Sec.

T.

R.

County Graham Elev. 2570 Co.
 Sec. 18 Twp. 7 Rge. 25W
 Company Brooks Hall & J-S-F
 Farm Name Brandt No. 2

| TOPS | DEPTH | LOG | DATUM | Loc. in Sec. |
|--------|-------|------|-------|---|
| Anh. | 2146 | | | NW NW NE |
| Tr. | | | | |
| H. | 3622 | 3624 | 1054 | |
| Tr. | 3642 | 3644 | 1074 | |
| Dg. | | | | |
| Bl. | | | | |
| L. | 3657 | 3660 | 1090 | Geol. |
| K.C. | | | | Contr. |
| B.K.C. | 3858 | 3858 | 1288 | J-S-F |
| Ce. | | | | |
| C. | | | | |
| M. | 4088 | 4091 | 1521 | Pool |
| M. | | | | Huntington |
| K. | | | | |
| Mz. | | | | |
| Mq. | | | | |
| V. | 4134 | 4134 | 1564 | <div style="border: 1px solid black; padding: 5px; text-align: center;"> COMPLETE APR 4 '55 </div> |
| S. | | | | |
| S. | | | | |
| A. | 4157 | 4160 | 1590 | |
| R. | | | | |
| Pe. | | | | |
| G. | | | | |
| T.D. | 4175 | | | |

Date Comm. 1-9-56 No. Sec. T. R.
 8 5/8" @ 305/150 DST 3677-95 open 1 hr
 rec. 120' gassy muddy oil 350' clean oil
 10 1/4" DST 3695-3710 open 15 min.
 rec. 5' mud 11 1/4/20" DST 3718-35
 open 1 hr. gas to surface in 15 min.
 rec. 610' free oil 30' gcm 1160/20"
 DST 3805-20 open 1 hr. rec. 1560' free
 oil 120' muddy oil 740/20"

DST 3830-40 open 1 hr. rec. 660' free
oil 30' gcm 940/20" 5 $\frac{1}{2}$ " @ 3900/100
CO 32/ 3832-40 S/ 14. bo 4 hr. 2000 A
P/ 70 bo 24 hr. Comp. 262 bopd

R. G.

APR 16 1956