


Graham

KANSAS

SECTION 18 TOWNSHIP 7S # RANGE 25W

WELL NO. #1 McFadden

COMPANY Isern Bros.

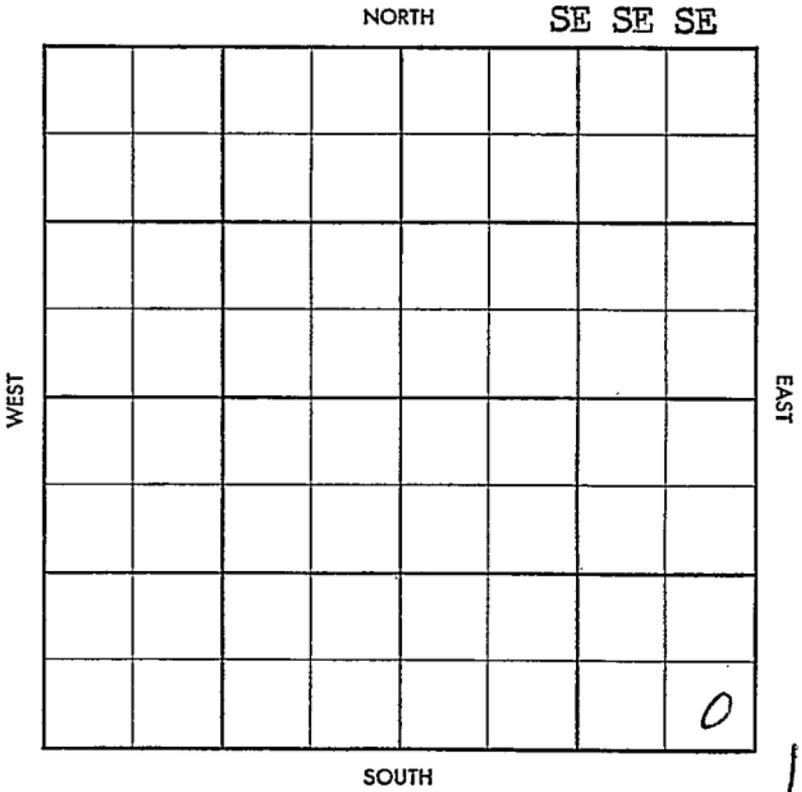

S-513-A

ABANDONED

~~Graden~~

ELEV. 2574cp

~~18~~

TWP 7

RGE. 25W

JAN 22 '58

COMPANY Isern Bros.

NO. 1

FARM M. Graden

Skelly - FO S/2 SE/4

LOC. SE SE SE

H 3701
TR 3720
L. 3737
TD 3962

GEOL.

CONTR. Co. Tools

POOL Ext. Blazier NW

SPUD 1/11/58

8" @ 235, WOC JAN 22 '58

DST 3748-70

60" 15' m BHP

1140/20" DST

3773-3913 60"

55' 50 cm BHP

1010/20" iron log

DBA

CO.

LS.

NO.

SEC.

TWP.

RGE.