

WELL COMPLETION REPORT AND DRILLER'S LOG

KANSAS

State Geological Survey
WICHITA BRANCH

API No. 15 — 163 — 21,260
County Number

S. 26 T. 7S R. 19 ¹/₄ E
Loc. 480' FNL & 330' FWL
County Rooks County

Operator
Texas Oil & Gas Corp.

Address
200 W. Douglas, Suite 300, Wichita, KS 67202


Well No. #1 Lease Name Biery

Footage Location
480' feet from (N) ^{XX} line 330' feet from (E) ^{XX} (W) line

Principal Contractor Geologist
Murfin, Rig #15 William Clark

Spud Date Date Completed Total Depth P.B.T.D.
4-16-81 4-24-81 3418' N/A

Directional Deviation Oil and/or Gas Purchaser
Not directionally drilled N/A

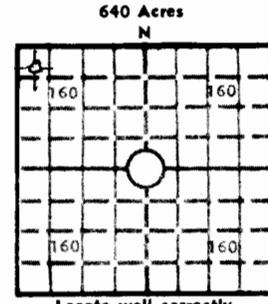

CASING RECORD

Report of all strings set — surface, intermediate, production, etc.

Purpose of string	Size hole drilled	Size casing set (in O.D.)	Weight lbs/ft.	Setting depth	Type cement	Sacks	Type and percent additives
Surface	12 1/2"	8-5/8"	24#	231		165	

LINER RECORD

PERFORATION RECORD

Top, ft.	Bottom, ft.	Sacks cement	Shots per ft.	Size & type	Depth interval
N/A	N/A	N/A	N/A	N/A	N/A

Size	Setting depth	Packer set at
N/A	N/A	N/A

ACID, FRACTURE, SHOT, CEMENT SQUEEZE RECORD

Amount and kind of material used	Depth interval treated
N/A	N/A

INITIAL PRODUCTION

Date of first production N/A Producing method (flowing, pumping, gas lift, etc.) Dry & abandoned

RATE OF PRODUCTION PER 24 HOURS	Oil	Gas	Water	Gas-oil ratio
	N/A bbls.	N/A MCF	N/A bbls.	N/A CFPB

Disposition of gas (vented, used on lease or sold) Dry & abandoned, 4-24-81 Producing interval(s) N/A

INSTRUCTIONS: As provided in KCC Rule 82-2-125, within 90 days after completion of a well, one completed copy of this Drillers Log shall be transmitted to the State Geological Survey of Kansas, 4150 Monroe Street, Wichita, Kansas 67209. Copies of this form are available from the Conservation Division, State Corporation Commission, 245 No. Water, Wichita, Kansas 67202. Phone AC 316-522-2206. If confidential custody is desired, please note Rule 82-2-125. Drillers Logs will be on open file in the Oil and Gas Division, State Geological Survey of Kansas, Lawrence, Kansas 66044.

FIELD: GROVER

Operator
Texas Oil & Gas Corp.

DESIGNATE TYPE OF COMP.: OIL, GAS,
DRY HOLE, SWDW, ETC.:
Dry hole

Well No.
#1

Lease Name
Biery

S 26 T 7S R 19 E^{1A} W

WELL LOG

Show all important zones of porosity and contents thereof; cored intervals, and all drill-stem tests, including depth interval tested, cushion used, time tool open, flowing and shut-in pressures, and recoveries.

SHOW GEOLOGICAL MARKERS, LOGS RUN, OR OTHER DESCRIPTIVE INFORMATION.

FORMATION DESCRIPTION, CONTENTS, ETC.	TOP	BOTTOM	NAME	DEPTH
LOG TOPS				
Herington	1891	+29		
Winfield	1948	-28		
Ft. Riley	2039	-119		
Florence	2086	-166		
Wreford	2153	-233		
Bader	2256	-336		
Cottonwood	2298	-378		
Red Eagle	2423	-503		
Foraker	2458	-538		
Tarkio	2729	-809		
Topeka	2860	-940		
Plattsmouth	3011	-1091		
Heebner	3065	-1145		
Toronto	3088	-1168		
Lansing	3104	-1184		
Wyandotte	3181	-1261		
Iola	3242	-1322		
Swope	3304	-1384		
B/KC	3335	-1415		
Arbuckle	3381	-1461		
TD	3418			
DST#1, 3256-75' (Lansing "I"), w/results as follows:				
IFP/30": 10-10#, weak blow, died				
ISIP/60": 31#				
FFP/45": 21-21#, no blow				
FSIP/90": 21#				
Rec: 1' mud				
DST #2, 3276-3303' (Kansas City "J"), w/results as follows:				
IFP/30": 31-31#, weak blow, died in 10"				
ISIP/60": 395#				
FFP/45": 42-42#, no blow				
FSIP/105": 352#				
Rec: 3' DM				
DST #3, 3383-3400' (Arbuckle), w/results as follows:				
IFP/30": 21-21#, weak blow, dead in 25"				
ISIP/60": 983#				
FFP/45": 53-53#, weak blow throughout				
FSIP/90": 930# Rec: 70' MW				
USE ADDITIONAL SHEETS, IF NECESSARY, TO COMPLETE WELL RECORD.				

RAN O.H. LOGS

Date Received

Harold R. Trapp
Harold R. Trapp
District Geologist

Signature

Title

April 28, 1981

Date