
KANSAS
FORM 51 5M PETROL

Graham

Section 2 Township 7 Range 21W

Well No. #1 Fitch

Company Texas

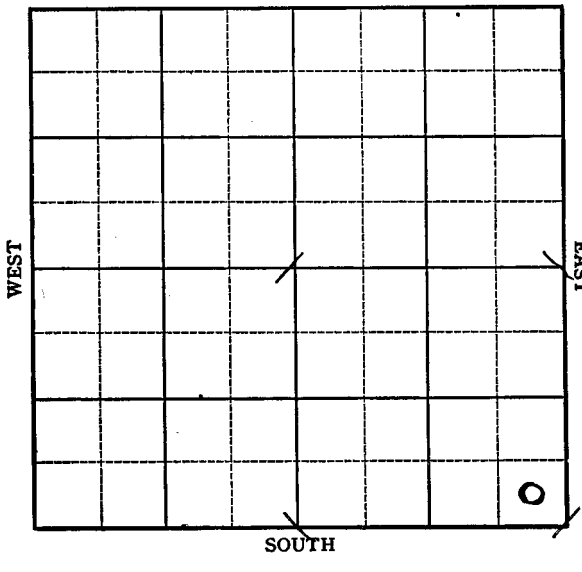

16

FORM 5M 5-44 PETROL

KANSAS

Graham

Sec. 2 Twp. 7 R. 21W

Well No. #1 Fitch Farm

Texas Company


Wildcat

_____ Ft. from N. Line

330 Ft. from S. Line

330 Ft. from E. Line

_____ Ft. from W. Line

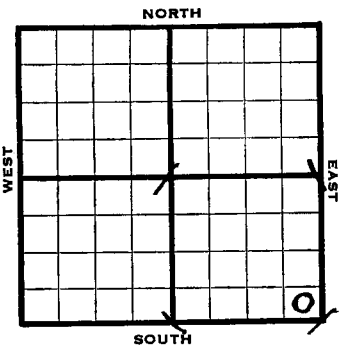

Elev. 2203

1944	REPORT
4/12	Location
4/19	"
4/26	Derrick
5/3	Rotary
5/10	Rigging up
5/17	Anhy 1764 Total Depth 1769 Running casing
5/24	10" @ 90' 9" @ 1768 Drlg. 3115'
5/31	Lans 3422 Arb. 3682 TD 3740 SSO
6/7	5" @ 3740' RUST
6/21	Arb. 3682 5" @ 3740 T.D. 3640 Perf. Lans & Arb. Water

ABANDONED

Form 26 200 Bks 5-42 Petrol Graham

KANSAS

Map No. 62 Sec. 2 Twp. 7 R. 21W


Well No. 1 Fitch

Texas Company

FIRST REPORT Contractor

SE/C

SECTION PLAT

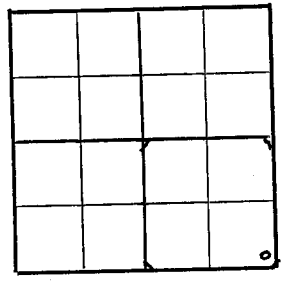

____ Ft. from N. Line

330 Ft. from S. Line

330 Ft. from E. Line

____ Ft. from W. Line

Wildcat

Location X

Rig up

Drilling and Remarks:

RECORD

Cased ____ in., ____ ft.

Sand

Gas

Oil

Total Depth

PRODUCTION

1st 24 hrs. Nat.

1st 24 hrs. after shot

Gas ____ Cu. Ft.

Dry Hole

Abandoned

Date

APR 12 1944 19____ S. J. LEWIS Scout

FORM 26 200 BKS. 1 44 PETROL

KANSAS

Pool Name Wildcat

Map No. (6) Sec. 2 Twp. 7 R. 21W


Well No. 1 Fitch

Texas Company

ABANDONED Contractor

SE/C

SECTION PLAT

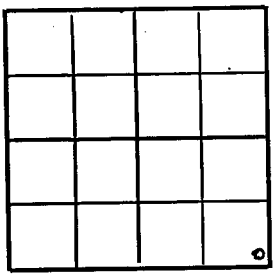

____ Ft. from N. Line

330 Ft. from S. Line

330 Ft. from E. Line

____ Ft. from W. Line

Graham County

Location

Rig up

Drilling and Remarks:

Oil & 3682

5" @ 3740

Perf Lane & Arb

Waters.

RECORD

Cased ____ in., ____ ft.

Sand

Gas

Oil

Total Depth 3740

PRODUCTION

1st 24 hrs. Nat.

1st 24 hrs. after shot

Gas ____ Cu. Ft.

Dry Hole

Abandoned

Date

JUN 21 1944 19

S. J. LEWIS Scout