


Section 2 Township 7 Range 19W

Well No. #1 Risley

Company Sohio & Rine Drlg.

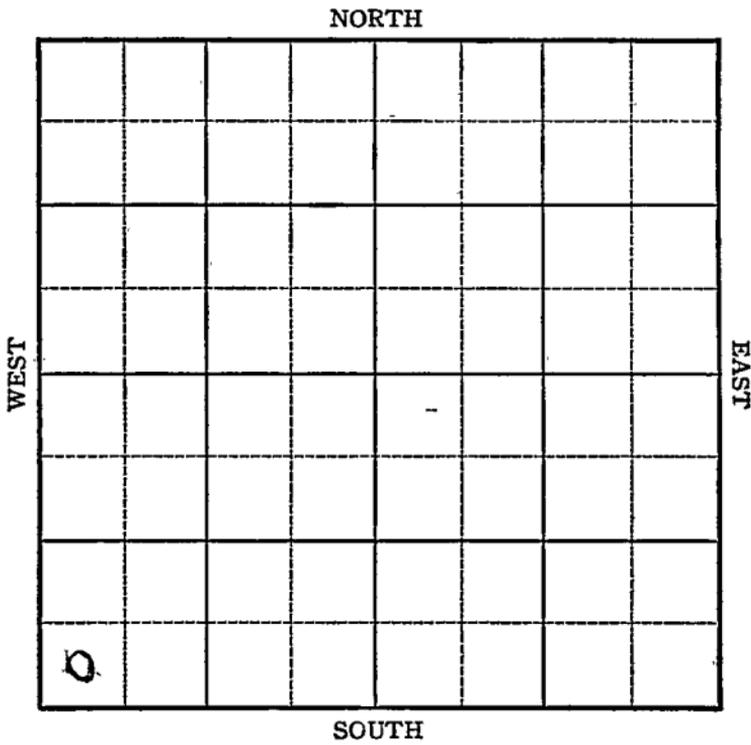

13

Sec. 2 **KANSAS** Twp. 7 R. 19W

Well No. #1 Risley Farm _____
Sohio & Rine Drlg. Company _____

Wildcat


_____ Ft. from N. Line

330 _____ Ft. from S. Line

_____ Ft. from E. Line

330 _____ Ft. from W. Line

SW/c

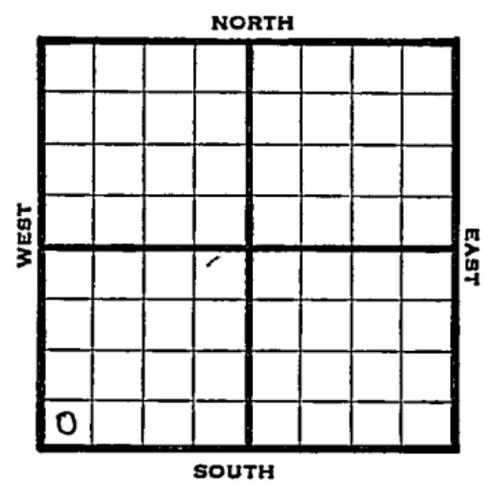

1946 Elev. 2009 REPORT

6/26 Location
7/3 "
7/9 8" @ 365'
Drlg 2420'
7/17 Lans 3206
Cong 3508
Arb. 3544
TD 3600'

ABANDONED

KANSAS Kansas Pool Name Wildcat
 Map No. 55 Sec. 2 Twp. 7 R. 19W

Well No. 1 Risley

Sohio & Rine Drlg. Company

FIRST REPORT

Contractor

SW/C

SECTION PLAT

 Ft. from N. Line

330 Ft. from S. Line

 Ft. from E. Line

330 Ft. from W. Line

Rooks County

RECORD

Location X

Cased in., ft.

Rig up

Sand

Drilling and Remarks:

Gas

Oil

Total Depth

PRODUCTION

1st 24 hrs. Nat.

1st 24 hrs. after shot

Gas Cu. Ft.

Dry Hole

Abandoned

Date

JUN 26 1946 19

S. J. LEWIS Scout

Pool Name Wildcat

KANSAS / ~~Kansas~~
 Map No. 60 Sec. 2 Twp. 7 R. 19W

Well No. 1 Risley

Sohio & Rine Drlg. Company

ABANDONED Contractor

SW/C

F1.2009
 SECTION PLAT

 Ft. from N. Line

330 Ft. from S. Line

 Ft. from E. Line

330 Ft. from W. Line

Rooks County

Location

Rig up

Drilling and Remarks:

Ham 3206
Cony 3508
Art 3544

RECORD

Cased in., ft.

Sand

Gas

Oil

Total Depth 3600

PRODUCTION

1st 24 hrs. Nat.

1st 24 hrs. after shot

Gas Cu. Ft.

Dry Hole

Abandoned

Date

JUL 17 1946 19

S. J. LEWIS Scout