

STATE CORPORATION COMMISSION OF KANSAS
OIL & GAS CONSERVATION DIVISION

WELL COMPLETION OR RECOMPLETION FORM
ACO-1 WELL HISTORY

DESCRIPTION OF WELL AND LEASE

Operator: License # 4483
Name JCR, Jr. - Operating, Inc.
Address P.O. Box 8246
City/State/Zip Amarillo, TX 79114

Purchaser Inland Purchasing & Transportation

Operator Contact Person Randy J. O'Neal
Phone (806) 358-1673

Contractor: License # 5422
Name Abercrombie Drilling, Inc.

Wellsite Geologist Rod Shank
Phone (806) 376-6136

Designate Type of Completion

☒ New Well ☐ Re-Entry ☐ Workover
☒ Oil ☐ SWD ☐ Temp Abd
☐ Gas ☐ Inj ☐ Delayed Comp.
☐ Dry ☐ Other (Core, Water Supply etc.)

If ONWO: old well info as follows:

Operator
Well Name
Comp. Date Old Total Depth

WELL HISTORY

Drilling Method:
☒ Mud Rotary ☐ Air Rotary ☐ Cable
7/16/85 7/22/85 8/8/85
Spud Date Date Reached TD Completion Date
3,650' 3,638'
Total Depth PBTD

Amount of Surface Pipe Set and Cemented at 366 feet
Multiple Stage Cementing Collar Used? ☒ Yes ☐ No
If yes, show depth set 1,710 feet
If alternate 2 completion, cement circulated
from 1,710 feet depth to surf w/ 450 SX cmt

SIDE ONE S

API NO. 15-163-22-718-2-7-20W

County Rooks

N/2 SE/4 NE/4 Sec 2 Twp 7S Rge 20 East West


3,630 Ft North from Southeast Corner of Section
660 Ft West from Southeast Corner of Section
(Note: Locate well in section plat below)

Lease Name Ross Well #1

Field Name

Producing Formation Lansing

Elevation: Ground 2,147' KB 2,152'
Section Plat

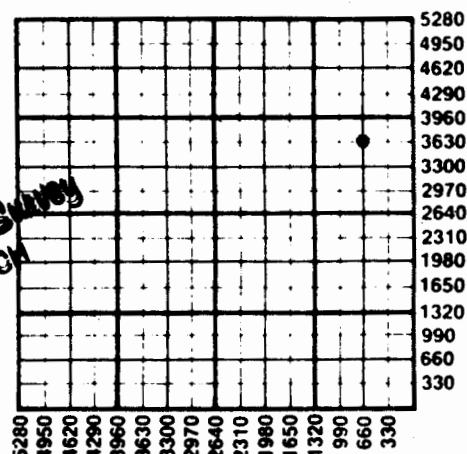

WATER SUPPLY INFORMATION

Disposition of Produced Water: ☒ Disposal
Docket # ☐ Repressuring

Questions on this portion of the ACO-1 call:
Water Resources Board (913) 296-3717

Source of Water:
Division of Water Resources Permit #

☐ Groundwater Ft North from Southeast Corner
(Well) Ft West from Southeast Corner of
Sec Twp Rge East West

☒ Surface Water 1320 Ft North from Southeast Corner
(Stream, pond etc) 4620 Ft West from Southeast Corner
Sec Twp Rge East West

☐ Other (explain)
(purchased from city, R.W.D. #)

INSTRUCTIONS: This form shall be completed in duplicate and filed with the Kansas Corporation Commission, 200 Colorado Derby Building, Wichita, Kansas 67202, within 90 days after completion or recompletion of any well. Rule 82-3-130 and 82-3-107 apply.

Information on side two of this form will be held confidential for a period of 12 months if requested in writing and submitted with the form. See rule 82-3-107 for confidentiality in excess of 12 months. One copy of all wireline logs and drillers time log shall be attached with this form. Submit CP-4 form with all plugged wells. Submit CP-111 form with all temporarily abandoned wells.