6-7-20W

SIDE ONE

STATE CORPORATION COMMISSION OF KANSAS
OIL & GAS CONSERVATION DIVISION
WELL COMPLETION OR RECOMPLETION FORM
ACO-1 WELL HISTORY
DESCRIPTION OF WELL AND LEASE

Operator: License # 4767
Name Ritchie Exploration, Inc.
Address 125 N. Market, Suite 1000
Wichita, KS 67202
City/State/Zip

Purchaser Koch Oil Company
Wichita, Kansas

Operator Contact Person Rocky Milford
Phone 316-267-4375

Contractor: License # 6033
Name Murfin Drilling Company

Wellsite Geologist Jeff Christian
Phone 316-267-4375

PLEASE KEEP THIS INFORMATION CONFIDENTIAL

Designate **Type of Completion**
X New Well ___ Re-Entry ___ Workover

___ Oil ___ SWD ___ Temp Abd
___ Gas ___ Inj ___ Delayed Comp.
___ Dry ___ Other (Core, Water Supply etc.)

If **OWWO:** old well info as follows:
Operator
Well Name
Comp. Date Old Total Depth

WELL HISTORY

Drilling Method:
X Mud Rotary ___ Air Rotary ___ Cable

9-24-87	10-1-87	10-21-87
Spud Date	Date Reached TD	Completion Date

3750'	N/A
Total Depth	PBTD

Amount of Surface Pipe Set and Cemented at 8-5/8" @ 217' feet
Multiple Stage Cementing Collar Used? X Yes ___ No
If yes, show depth set 1834 feet
If alternate 2 completion, cement circulated from 1834 feet depth to surface w/ 475 SX cmt
Cement Company Name Allied Cementing
Invoice # 49849

S

API NO. 15- 163-22,948
County Rooks
NE SE NW Sec. 6 Twp. 7 Rge. 20 ___ East X West
3630 Ft North from Southeast Corner of Section
2970 Ft West from Southeast Corner of Section
(Note: Locate well in section plat below)

Lease Name Waller Well # 1

Field Name

Producing Formation Lansing

Elevation: Ground 2213' KB 2218'

Section Plat

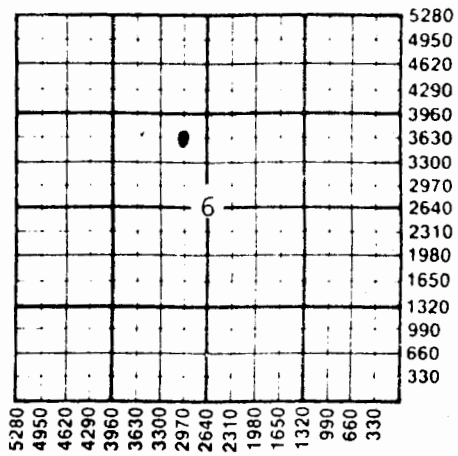

WATER SUPPLY INFORMATION

Disposition of Produced Water: ___ **Disposal**
Docket # ___ **Repressuring**
No water at present.

Questions on this portion of the ACO-1 call:
Water Resources Board (913) 296-3717
Source of Water: Hauled.
Division of Water Resources Permit #

___ Groundwater Ft North from Southeast Corner
(Well) Ft West from Southeast Corner of
Sec Twp Rge ___ East ___ West

___ Surface Water Ft North from Southeast Corner
(Stream, pond etc) Ft West from Southeast Corner
Sec Twp Rge ___ East ___ West

___ Other (explain)
(purchased from city, R.W.D. #)

INSTRUCTIONS: This form shall be completed in triplicate and filed with the Kansas Corporation Commission, 200 Colorado Derby Building, Wichita, Kansas 67202, within 120 days of the spud date of any well. Rule 82-3-130, 82-3-107 and 82-3-106 apply.
Information on side two of this form will be held confidential for a period of 12 months if requested in writing and submitted with the form. See rule 82-3-107 for confidentiality in excess of 12 months.
One copy of all wireline logs and drillers time log shall be attached with this form. Submit CP-4 form with all plugged wells. Submit CP-111 form with all temporarily abandoned wells.