

STATE CORPORATION COMMISSION OF KANSAS
OIL & GAS CONSERVATION DIVISION
WELL COMPLETION OR RECOMPLETION FORM
ACO-1 WELL HISTORY
DESCRIPTION OF WELL AND LEASE

Operator: License # 04981
Name Cholla Resources, Inc.
Address P.O. Box 1428
City/State/Zip Golden, CO 80402-1428

Purchaser

Operator Contact Person William Goff
Phone (303) 526-1425

Contractor: License # 9087
Name R & C Drilling Co., Inc.

Wellsite Geologist William Goff
Phone (303) 526-1425

Designate Type of Completion
☒ New Well ☐ Re-Entry ☐ Workover
☐ Oil ☐ SWD ☐ Temp Abd
☐ Gas ☐ Inj ☐ Delayed Comp.
☒ Dry ☐ Other (Core, Water Supply etc.)
If **OWWO**: old well info as follows:
Operator
Well Name
Comp. Date Old Total Depth

WELL HISTORY

Drilling Metho :
☒ Mud Rotary ☐ Air Rotary ☐ Cable
2-5-87 2-11-87 2-12-87
Spud Date Date Reached TD Completion Date
3570
Total Depth PBTD

Amount of Surface Pipe Set and Cemented at 213 feet
Multiple Stage Cementing Collar Used? Yes No
If yes, show depth set feet
If alternate 2 completion, cement circulated
from feet depth to w/ SX cmt
Cement Company Name
Invoice #

SIDE ONE

API NO. 15-163-22,912

County Rooks

SW SW NE Sec 21 Twp 7S Rge 20 East
West

2970
2160
Ft North from Southeast Corner of Section
Ft West from Southeast Corner of Section
(Note: Locate well in section plat below)


Lease Name J. Bellerive Well # 1

Field Name

Producing Formation

Elevation: Ground 2033 KB 2030

Section Plat

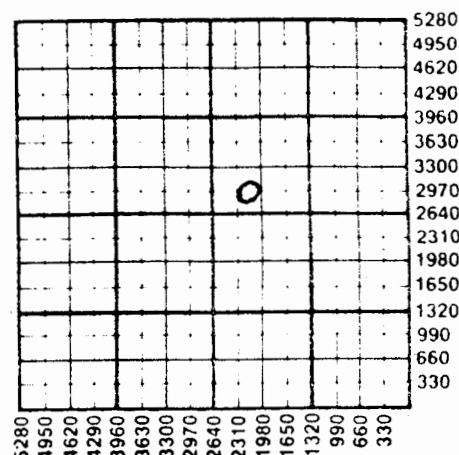

WATER SUPPLY INFORMATION

Disposition of Produced Water: Disposal
Docket # Repressuring

Questions on this portion of the ACO-1 call:

Water Resources Board (913) 296-3717

Source of Water:
Division of Water Resources Permit #

Groundwater Ft North from Southeast Corner
(Well) Ft West from Southeast Corner of
Sec Twp Rge East West

Surface Water Ft North from Southeast Corner
(Stream, pond etc) Ft West from Southeast Corner
Sec Twp Rge East West

Other (explain)
(purchased from city, R.W.D. #)

INSTRUCTIONS: This form shall be completed in triplicate and filed with the Kansas Corporation Commission, 200 Colorado Derby Building, Wichita, Kansas 67202, within 120 days of the spud date of any well. Rule 82-3-130, 82-3-107 and 82-3-106 apply.

Information on side two of this form will be held confidential for a period of 12 months if requested in writing and submitted with the form. See rule 82-3-107 for confidentiality in excess of 12 months. One copy of all wireline logs and drillers time log shall be attached with this form. Submit CP-4 form with all plugged wells. Submit CP-111 form with all temporarily abandoned wells.