


# KANSAS

FORM 51 5M BRIX

Section 20 Township 7 Range 16W

Well No. 1 Budd

Company Eldorado Ref.

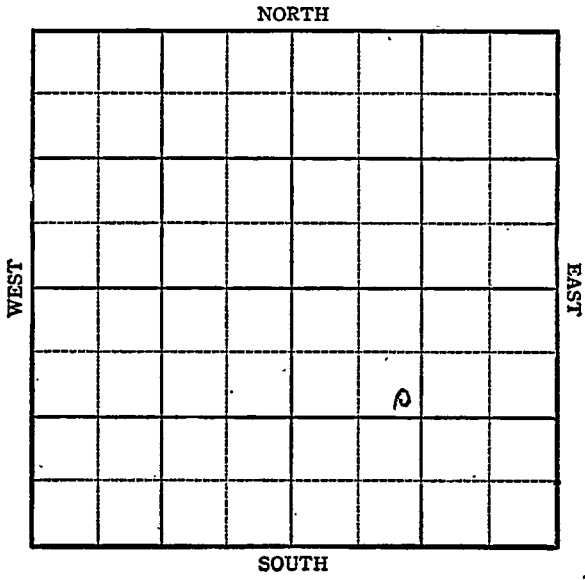

10

# KANSAS

## Rooks

Sec. 20 Twp. 7 R. 16W

Well No. #1 Budd Farm

Eldorado Ref Company

Wildcat  
990


Ft. from N. Line

Ft. from S. Line

Ft. from E. Line

990

Ft. from W. Line

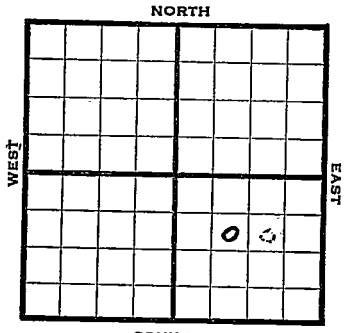

1944

### REPORT

8/30

Rotary

9/8

12" @ 151  
1295 Run 8"

9/13

8" @ 1166 = Drlg. 2255'

9/20

Topeka 2668  
Lans 2932  
Arb. 3292'  
TD23320'

**ABANDONED**



