

Section 20 Township 7 Range 16 WWell No. # 1 CordillCompany Petroleum Inc.

NORTH

			0				

WEST

EAST

SOUTH

6

Rooks

KANSAS

SEC.	20	TWP.	7	R.	16W
------	----	------	---	----	-----

WELL NO.

#1 Cordill

COMPANY

Petroleum Inc.

FARM

CONTRACTOR

Petroleum

Wildcat

Ft. from N. Line

330


Ft. from S. Line

330

Ft. from E. Line

Ft. from W. Line

SE SE NW

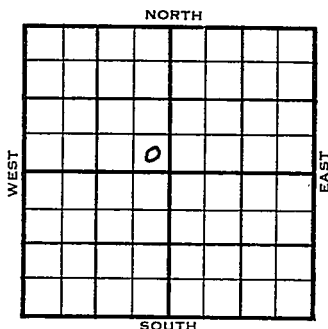

	ELEVATION	REPORT
1953	1717'	
10/14	M I M	
10/21	8" @ 162' Anhy 1065' Drlg. 2037'	
10/28	Top 2612' DST 2635-48, 35 mins, 15' M Heeb 2808' Lans 2873' DST 2810-80, 1 hr, 80' M 850# DST 2834-2913', 1/2 hr, 10' M 150# DST 2921-80, 1/2 hr, 10' M 850# Drlg. 3040'	
10/4	Spud 10-14-53 D & A TD 3270' 8" @ 162 Anhy 1065 Top 2612 DST 2635-48 open 35 min rec 15' mud Heeb 2808 Lans 2873 DST 2810-80 open 1 hr rec 80' mud 850 # DST 2834-2913 open 1/2 hr rec 10' mud 150# DST 2921-80 open 1/2 hr rec 10' mud 850# Cong. 3228' Arb. 3234' TD 3270' D & A	
	ABANDONED	

J. G. McGEHEE

J. G. McGEHEE