

7-7-21W

APL NO. 15-.....

County.....Graham.....
30' W of East
NE NW NW Sec. 7 Twp. 7S Rge. 21, X West

4950..... Ft North from Southeast Corner of Section
4320..... Ft West from Southeast Corner of Section
(Note: Locate well in section plat below)


Lease Name..... Anita Davis Well #..... 1

Field Name.....

Producing Formation.....Lansing.....

Elevation: Ground.....2210'.....KB.....2215'.....

Section Plot

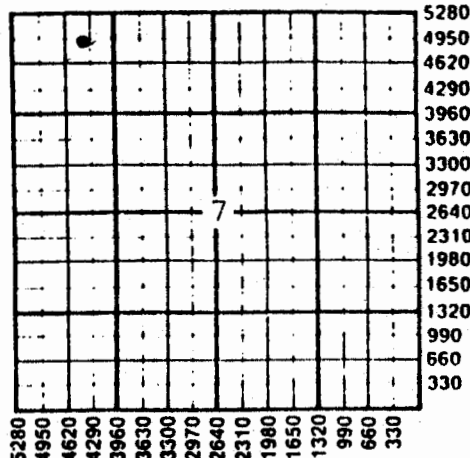

WELL HISTORY

WATER SUPPLY INFORMATION

Disposition of Produced Water: X Disposal
Docket # D-20,496 Repressuring

Questions on this portion of the ACO-1 call:

Water Resources Board (913) 296-3717

Source of Water: Hauled.

Division of Water Resources Permit #.....

Groundwater.....Ft North from Southeast Corner
(Well)Ft West from Southeast Corner of
Sec Twp Rge East West

Surface Water.....Ft North from Southeast Corner
(Stream,pond etc).....Ft West from Southeast Corner

Sec	Two	Roe	East	West
-----	-----	-----	------	------

Other (explain).....
(purchased from city, R.W.D. #)

INSTRUCTIONS: This form shall be completed in triplicate and filed with the Kansas Corporation Commission, 200 Colorado Derby Building, Wichita, Kansas 67202, within 120 days of the spud date of any well. Rule 82-3-130, 82-3-107 and 82-3-106 apply. Information on side two of this form will be held confidential for a period of 12 months if requested in writing and submitted with the form. See rule 82-3-107 for confidentiality in excess of 12 months. One copy of all wireline logs and drillers time log shall be attached with this form. Submit CP-4 form with all plugged wells. Submit CP-111 form with all temporarily abandoned wells.

All requirements of the statutes, rules and regulations promulgated to regulate the oil and gas industry have been fully complied with and the statements herein are complete and correct to the best of my knowledge.

Signature [Signature]
Title Vice President Date 9/27/88

Subscribed and sworn to before me this 27th day of September 1988.

Notary Public Linda K. Rice

LINDA K. RICE
NOTARY PUBLIC

Date Commission Expires... 6/07/92

K.C.C. OFFICE USE ONLY

F ☒ Letter of Confidentiality Attached
C ☒ Wireline Log Received
C ☐ Drillers Timelog Received

Distribution

☐ KCC	☐ SWD/Rep	☐ NGPA
☒ KGS	☐ Plug	☐ Other
		(Specify)

.....

OCT 03 1988

SEP 2 1988 Form ACO-1 (5-86)

KANSAS GEOLOGICAL SURVEY
WICHITA BRANCH